DIRECTION	MILEPOINT	LOCATION CODE (SHEET 2)	SIGN CODE	WIDTH (IN)	HEIGHT (IN)	SHEETING REMARKS	SIGN LEGEND	NEW SIGNS "A"	NEW SIGNS "B"	EXISTING SIGNS RETAIN	EXISTING SIGNS SALVAGE FROM	EXISTING SIGNS SALVAGE TO	EXISTING SIGNS REMOVE	EXIST POST RETAIN	EXIST POST REMOVE	NUMBER OF NEW POSTS	SQUARE STEEL (IN) (LB / FT) 1.75 / 1.88	SQUARE STEEL (IN) (LB / FT) 2.00 / 2.42	SQUARE STEEL (IN) (LB / FT) 2.50 / 3.35	TUBULAR STEEL Ø (IN) FOUNDATION (LB / FT) 3.00 / 7.60	TUBULAR STEEL Ø (IN) FOUNDATION (LB / FT) 3.50 / 9.00	TUBULAR STEEL Ø (IN) FOUNDATION (LB / FT) 4.00 / 10.80	TUBULAR STEEL Ø (IN) FOUNDATION (LB / FT) 5.00 / 14.60	SIGN FRAME REQUIRED	REMARKS	SIGN DETAIL: DETAIL IN SHS	SIGN DETAIL: DETAIL ON SHEET NUMBER	SIGN DETAIL: DETAIL ON STD SHEET NUMBER
BRIGHTON VT 105							FY-FLUORESCENT YELLOW FYG-FLUORESCENT YELLOW GREEN																		"SHS"-STANDARD HIGHWAY SIGNS			
WB	4.705	F	VD-018	30	18		VILLAGE SIGN						1		X												
WB	4.680	F	R2-1	24	30								1		X												
		F	R2-1	30	36			7.50								1	15.3 X									6	
WB	4.665	F	W1-8	18	24		CHEVRON						1		X												
		E	W1-8	18	24		CHEVRON 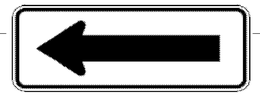						1														
		F	W1-6L	48	24			8.00								2	10 15.3 X									X	
WB	4.635	F	W1-8	18	24		CHEVRON						1		X												
		E	W1-8	18	24		CHEVRON						1														
WB	4.615	G	VR-017	24	30								1												TH-20, CURRAN AVE			
		G	VR-017	24	30			5.00								1	15 X										E-141
WB	4.620	H	R1-1	30	30								1	X											TH-20, CURRAN AVE			
		H	R1-1	30	30			6.25								1	13.5 X									X	
WB	4.605	F	W1-8	18	24		CHEVRON						1		X												
		E	W1-8	18	24		CHEVRON 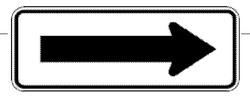						1														
		E	W1-6R	48	24			8.00								2	12 12.3 X									X	
							SHEET TOTALS	34.75 SF	0.00 SF	0 EA	0 EA	0 EA	10 ~~9~~ EA	0 EA	0 EA	7 EA	~~105~~ 93.4 FT										
							TOWN TOTALS	729.8	0.0	4.0	2.0	2.0	165	0.0	0.0	129	1935.0										

SIGN SUMMARY SHEET

VERMONT AGENCY OF TRANSPORTATION

PROJECT NAME: **Derby-Bloomfield VT105**
PROJECT NUMBER: **STPG SIGN(22)**

FILE NAME: **Brighton.xls**
PROJECT MANAGER: **N. Avery**
DESIGNED BY: **J. Kelly**
BRIGHTON SHEET 16

PLOT DATE: **6/11/2009**
DRAWN BY: **T. Guazzoni**
CHECKED BY: **S. Menard**
SHEET **52** OF **79**