DIRECTION	MILEPOINT	LOCATION CODE (SHEET 2)	SIGN CODE	WIDTH (IN)	HEIGHT (IN)	SHEETING REMARKS	SIGN LEGEND	NEW SIGNS "A"	NEW SIGNS "B"	EXISTING SIGNS RETAIN	EXISTING SIGNS SALVAGE FROM	EXISTING SIGNS SALVAGE TO	EXISTING SIGNS REMOVE	EXIST POST RETAIN	EXIST POST REMOVE	NUMBER OF NEW POSTS	SQUARE STEEL (IN) 1.75 (LB / FT) 1.88	SQUARE STEEL (IN) 2.00 (LB / FT) 2.42	SQUARE STEEL (IN) 2.50 (LB / FT) 3.35	FOUNDATION	TUBULAR STEEL Ø (IN) 3.00 (LB / FT) 7.60	TUBULAR STEEL Ø (IN) 3.50 (LB / FT) 9.00	TUBULAR STEEL Ø (IN) 4.00 (LB / FT) 10.80	TUBULAR STEEL Ø (IN) 5.00 (LB / FT) 14.60	SIGN FRAME REQUIRED	REMARKS	SIGN DETAIL: DETAIL IN SHS	SIGN DETAIL: DETAIL ON SHEET NUMBER	SIGN DETAIL: DETAIL ON STD SHEET NUMBER
BRIGHTON VT 105							FY-FLUORESCENT YELLOW FYG-FLUORESCENT YELLOW GREEN																			"SHS"-STANDARD HIGHWAY SIGNS			
WB	2.255	F	D1-1A	72	10								1		X													
		F	D1-1A	72	10								1															
		F	D1-1A	72	10								1															
		F	D1-1A	72	10								1															
		F	D1-1A	72	12		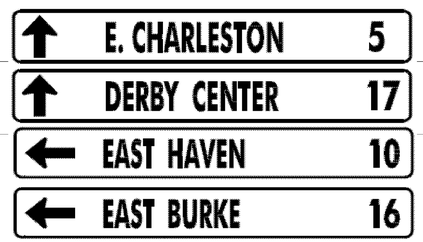	6.00								2			14.8 15.5 X							5	
		F	D1-1A	72	12			6.00																			5	
		F	D1-1A	72	12			6.00																			5	
		F	D1-1A	72	12			6.00																			5	
WB	2.210	G	VM-607	24	30		MEMORIAL HIGHWAY			1				X														
WB	2.200	F	M3-3	24	12								1		X													
		F	M1-5A	24	24								1															
		F	M6-1	21	15								1															
		F	M3-4	24	12								1															
		F	M1-5A	24	24								1															
		F	M6-2	21	15								1															
							SHEET TOTALS	24.00	0.00	1	0	0	10	0	0	2	~~30~~ 30.3											
								SF	SF	EA	EA	EA	EA	EA	EA	EA	FT											
							TOWN TOTALS	729.8	0.0	4.0	2.0	2.0	165	0.0	0.0	129	1935.0											

SIGN SUMMARY SHEET

VERMONT AGENCY OF TRANSPORTATION

PROJECT NAME: Derby-Bloomfield VT105
PROJECT NUMBER: STPG SIGN(22)

FILE NAME: Brighton.xls
PROJECT MANAGER: N. Avery
DESIGNED BY: J. Kelly
BRIGHTON SHEET 19

PLOT DATE: 6/11/2009
DRAWN BY: T. Guazzoni
CHECKED BY: S. Menard
SHEET 55 OF 79