DIRECTION	MILEPOINT	LOCATION CODE (SHEET 2)	SIGN CODE	WIDTH (IN)	HEIGHT (IN)	SHEETING REMARKS	SIGN LEGEND	NEW SIGNS "A"	NEW SIGNS "B"	EXISTING SIGNS RETAIN	EXISTING SIGNS SALVAGE FROM	EXISTING SIGNS SALVAGE TO	EXISTING SIGNS REMOVE	EXIST POST RETAIN	EXIST POST REMOVE	NUMBER OF NEW POSTS	SQUARE STEEL (IN) 1.75 (LB/FT) 1.88	SQUARE STEEL (IN) 2.00 (LB/FT) 2.42	SQUARE STEEL (IN) 2.50 (LB/FT) 3.35	TUBULAR STEEL Ø (IN) FOUNDATION	TUBULAR STEEL Ø (IN) 3.00 (LB/FT) 7.60	TUBULAR STEEL Ø (IN) 3.50 (LB/FT) 9.00	TUBULAR STEEL Ø (IN) 4.00 (LB/FT) 10.80	TUBULAR STEEL Ø (IN) 5.00 (LB/FT) 14.60	SIGN FRAME REQUIRED	REMARKS	SIGN DETAIL: DETAIL IN SHS	SIGN DETAIL: DETAIL ON SHEET NUMBER	SIGN DETAIL: DETAIL ON STD SHEET NUMBER
BRIGHTON VT 105							FY-FLUORESCENT YELLOW FYG-FLUORESCENT YELLOW GREEN																			"SHS"-STANDARD HIGHWAY SIGNS			
		F	M3-3	24	12			2.00								2		14.8 14.7 X							#2B	GREEN ON WHITE SHEETING	X	7	
		F	M1-5	30	24		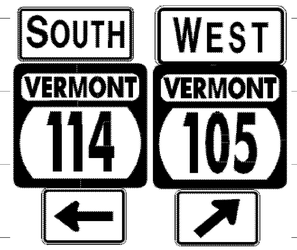	5.00																				E-136B
		F	M6-1L	21	15			2.19																		GREEN ON WHITE SHEETING	X		
		F	M3-4	24	12			2.00																		GREEN ON WHITE SHEETING	X		
		F	M1-5	30	24			5.00																				E-136B
		F	M6-2R	21	15			2.19																		GREEN ON WHITE SHEETING	X		
WB	2.195	G	W1-7	48	24								1		X													
		G	W1-7	48	24			8.00								2		12.3 12.3 X								INSTALL ACROSS FROM CENTERLINE OF VT-114	X		
WB	2.170	F	M3-4S	24	12		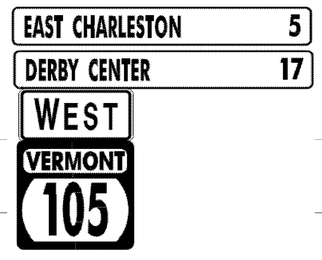						1		X														
		F	M1-5	30	24								1															
		F	D2-1	72	12			6.00								2		15.5 16.5 X										5	
		F	D2-1	72	12			6.00																				5	
		F	M3-4S	24	12			2.00																		GREEN ON WHITE SHEETING	X		
		F	M1-5	30	24			5.00																				E-136B
WB	2.130	F	D2-1	72	10		EAST CHARLESTON 5						1		X													
							SHEET TOTALS	45.38	0.00	0	0	0	4	0	0	6		~~90~~ 86.1										
								SF	SF	EA	EA	EA	EA	EA	EA	EA		FT										
							TOWN TOTALS	729.8	0.0	4.0	2.0	2.0	165	0.0	0.0	129		1935.0										

SIGN SUMMARY SHEET

VERMONT AGENCY OF TRANSPORTATION

PROJECT NAME: **Derby-Bloomfield VT105**
PROJECT NUMBER: **STPG SIGN(22)**

FILE NAME: **Brighton.xls** PLOT DATE: **6/11/2009**
PROJECT MANAGER: **N. Avery** DRAWN BY: **T. Guazzoni**
DESIGNED BY: **J. Kelly** CHECKED BY: **S. Menard**
BRIGHTON SHEET 20 SHEET **56** OF **79**