SIGN SUMMARY SHEET

VERMONT AGENCY OF TRANSPORTATION

BRIGHTON VT 105

FY-FLUORESCENT YELLOW
FYG-FLUORESCENT YELLOW GREEN

"SHS"-STANDARD HIGHWAY SIGNS

DIRECTION	MILEPOINT	LOCATION CODE (SHEET 2)	SIGN CODE	WIDTH (IN)	HEIGHT (IN)	SHEETING REMARKS	SIGN LEGEND	NEW SIGNS "A"	NEW SIGNS "B"	EXISTING SIGNS RETAIN	EXISTING SIGNS SALVAGE FROM	EXISTING SIGNS SALVAGE TO	EXISTING SIGNS REMOVE	EXIST POST RETAIN	EXIST POST REMOVE	NUMBER OF NEW POSTS
WB	0.940	F	S3-1	30	30		SCHOOL BUS STOP AHEAD						1		X	
WB	0.920	F	VW-205	30	30		WATCH FOR TURNING VEHICLES						1		X	
WB	0.910	F	W2-2MaL	30	30		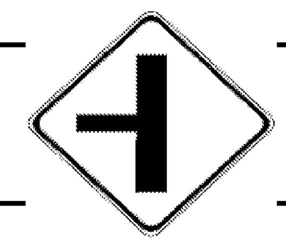	6.25								1
WB	0.820	F	M1-5A	24	24		ROUTE 105						1		X	
WB	0.000	G	VD-024	60	7.5		CHARLESTON/BRIGHTON						1		X	
		G	VD-025	60	7.5		ORLEANS CO/ESSEX CO						1			
							MILEMARKER						1			
							SHEET TOTALS	6.25	0.00	0	0	0	~~5~~ 6	0	0	1
								SF	SF	EA	EA	EA	EA	EA	EA	EA
							TOWN TOTALS	~~729.8~~ 729.99	0.0	4.0	2.0	2.0	~~165~~ 169	0.0	0.0	129

SIGN CODE	SQUARE STEEL (IN) 1.75 (1.88 LB/FT)	SQUARE STEEL 2.00 (2.42 LB/FT)	SQUARE STEEL 2.50 (3.35 LB/FT)	FOUNDATION	TUBULAR STEEL Ø (IN) 3.00 (7.60 LB/FT)	TUBULAR STEEL 3.50 (9.00 LB/FT)	TUBULAR STEEL 4.00 (10.80 LB/FT)	TUBULAR STEEL 5.00 (14.60 LB/FT)	SIGN FRAME REQUIRED	REMARKS	DETAIL IN SHS	DETAIL ON SHEET NUMBER	DETAIL ON STD SHEET NUMBER
S3-1													
VW-205													
W2-2MaL		13.5 X								INSTALL 50 FEET EAST OF EXISTING WATCH FOR TURNING VEHICLES SIGN.		6	
M1-5A													
VD-024													
VD-025													
SHEET TOTALS		~~15~~ 13.5											
		FT											
TOWN TOTALS		1935.0											

PROJECT NAME:	Derby-Bloomfield VT105		
PROJECT NUMBER:	STPG SIGN(22)		
FILE NAME:	Brighton.xls	PLOT DATE:	6/11/2009
PROJECT MANAGER:	N. Avery	DRAWN BY:	T. Guazzoni
DESIGNED BY:	J. Kelly	CHECKED BY:	S. Menard
BRIGHTON SHEET 22		SHEET 58	OF 79