DIRECTION	MILEPOINT	LOCATION CODE (SHEET 2)	SIGN CODE	WIDTH (IN)	HEIGHT (IN)	SHEETING REMARKS	SIGN LEGEND	NEW SIGNS "A"	NEW SIGNS "B"	EXISTING SIGNS RETAIN	EXISTING SIGNS SALVAGE FROM	EXISTING SIGNS SALVAGE TO	EXISTING SIGNS REMOVE	EXIST POST RETAIN	EXIST POST REMOVE	NUMBER OF NEW POSTS	SQUARE STEEL (IN) 1.75 (LB / FT) 1.88	SQUARE STEEL (IN) 2.00 (LB / FT) 2.42	SQUARE STEEL (IN) 2.50 (LB / FT) 3.35	TUBULAR STEEL Ø (IN) FOUNDATION	TUBULAR STEEL Ø (IN) 3.00 (LB / FT) 7.60	TUBULAR STEEL Ø (IN) 3.50 (LB / FT) 9.00	TUBULAR STEEL Ø (IN) 4.00 (LB / FT) 10.80	TUBULAR STEEL Ø (IN) 5.00 (LB / FT) 14.60	SIGN FRAME REQUIRED	REMARKS	SIGN DETAIL: DETAIL IN SHS	SIGN DETAIL: DETAIL ON SHEET NUMBER	SIGN DETAIL: DETAIL ON STD SHEET NUMBER
FERDINAND VT 105							FY-FLUORESCENT YELLOW FYG-FLUORESCENT YELLOW GREEN																			"SHS"-STANDARD HIGHWAY SIGNS			
		A	W16-4	24	18								1																
		A	W13-1	24	24		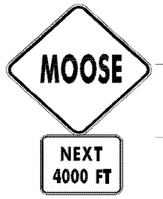						1																
		A	VW-001	30	30			6.25								1		12.8 X									6	
		A	W16-4	24	18			3.00																		X		
WB	4.540	F	W1-2R	30	30		CURVE RIGHT	6.25								1		14.8 X								INSTALL 170 FEET EAST OF UTILITY POLE #651 1/2	X		
WB	3.480	G	VR-023B	24	30		$500 FINE						1		X														
		G	VM-607	24	30		PEARL HARBOR				1	1				1		13.5 X										
		G	VR-278	24	36		PROHIBITED DUMPING						1																
WB	3.100	F	W10-1	36	36								1		X														
		F	W10-1	36	36			7.07								1		13.8 X								X		
WB	1.200	F	W11-6H	30	30		SNOWMOBILE (FOLDING)						1		X														
WB	0.000	G	VD-024	60	7.5		BRIGHTON/FERDINAND						1		X														

SIGN SUMMARY SHEET

VERMONT AGENCY OF TRANSPORTATION

SHEET TOTALS	22.57	0.00	0	1	1	7	0	0	4	~~60~~ 54.9							
	SF	SF	EA	EA	EA	EA	EA	EA	EA	FT							
TOWN TOTALS	75.3	0.0	0.0	1.0	1.0	12	0.0	0.0	30	450.0							

PROJECT NAME: **Derby-Bloomfield VT105**
PROJECT NUMBER: **STPG SIGN(21)**

FILE NAME: **Ferdinand.xls**
PROJECT MANAGER: **N. Averv**
DESIGNED BY: **A. Gamble**
FERDINAND SHEET 2

PLOT DATE: **6/11/2009**
DRAWN BY: **T. Guazzoni**
CHECKED BY: **S. Menard**
SHEET **60** OF **79**