DIRECTION	MILEPOINT	LOCATION CODE (SHEET 2)	SIGN CODE	WIDTH (IN)	HEIGHT (IN)	SHEETING REMARKS	SIGN LEGEND	NEW SIGNS "A"	NEW SIGNS "B"	EXISTING SIGNS RETAIN	EXISTING SIGNS SALVAGE FROM	EXISTING SIGNS SALVAGE TO	EXISTING SIGNS REMOVE	EXIST POST RETAIN	EXIST POST REMOVE	NUMBER OF NEW POSTS	SQUARE STEEL (IN) 1.75 (LB/FT) 1.88	SQUARE STEEL (IN) 2.00 (LB/FT) 2.42	SQUARE STEEL (IN) 2.50 (LB/FT) 3.35	TUBULAR STEEL Ø (IN) FOUNDATION	TUBULAR STEEL Ø (IN) 3.00 (LB/FT) 7.60	TUBULAR STEEL Ø (IN) 3.50 (LB/FT) 9.00	TUBULAR STEEL Ø (IN) 4.00 (LB/FT) 10.80	TUBULAR STEEL Ø (IN) 5.00 (LB/FT) 14.60	SIGN FRAME REQUIRED	REMARKS	SIGN DETAIL: DETAIL IN SHS	SIGN DETAIL: DETAIL ON SHEET NUMBER	SIGN DETAIL: DETAIL ON STD SHEET NUMBER
BRUNSWICK VT 105							FY-FLUORESCENT YELLOW FYG-FLUORESCENT YELLOW GREEN																			"SHS"-STANDARD HIGHWAY SIGNS			
WB	1.500	F	W9-1	30	30			6.25								1		14.5 X								INSTALL 200 FEET IN ADVANCE OF W4-2R SIGN, BEHIND RAIL AND IN FRONT OF POLE	X		
WB	1.460	F	W4-2R	30	30								1		X														
		F	W4-2R	30	30			6.25								1		13.5 X									X		
WB	1.410	F	W1-4L	30	30			6.25								1		13 X								INSTALL 250 FT +/- WEST OF LANE ENDS SIGN	X		
WB	1.390	F	VR-186E	24	30		TRUCK LANE ENDS						1		X														
WB	1.390 TO 1.320	F	N/A	6	8		10 WHITE DELINEATORS	3.33								5		6 x 3 6.3 x 2 X								INSTALL BACK TO BACK AT 100' SPACING, STARTING AT EXISTING TRUCK LANE ENDS SIGN		5	
WB	1.020	F	W1-2R	30	30			6.25								1		14 X								INSTALL 250 FT +/- WEST OF SILVIO O. CONTE DRIVEWAY			
WB	0.825	F	VW-001	30	30		MOOSE						1		X														
		F	W13-1	24	24		40 MPH PLAQUE						1																
		F	W16-4	24	18		4000 FT						1																
WB	0.800	F	W1-2L	30	30		LEFT CURVE						1		X														
		F	VW-001	30	30			6.25								1		15.3 X											E-153
		F	W16-4	24	18			3.00																			X		
WB	0.740	F	S3-1	30	30		SCHOOL BUS STOP AHEAD						1		X														
WB	0.685	F	W1-2L	30	30		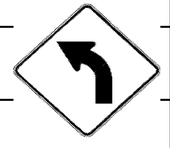	6.25								1		13.8 X								INSTALL 300 FT +/- WEST OF EXISTING SCHOOL BUS STOP AHEAD	X		
							SHEET TOTALS	43.83 SF	0.00 SF	0 EA	0 EA	0 EA	7 EA	0 EA	0 EA	11 EA			~~165~~ 114.7 FT							
							TOWN TOTALS	160.6	0.0	0.0	0.0	0.0	22	0.0	0.0	54			810.0										

SIGN SUMMARY SHEET

VERMONT AGENCY OF TRANSPORTATION

PROJECT NAME: **Derby-Bloomfield VT105**
PROJECT NUMBER: **STPG SIGN(22)**

FILE NAME: **Brunswick.xls**
PROJECT MANAGER: **N. Averv**
DESIGNED BY: **M. Miller**
BRUNSWICK SHEET 3

PLOT DATE: **6/11/2009**
DRAWN BY: **I. Shea**
CHECKED BY: **S. Menard**
SHEET **63** OF **79**