DIRECTION	MILEPOINT	LOCATION CODE (SHEET 2)	SIGN CODE	WIDTH (IN)	HEIGHT (IN)	SHEETING REMARKS	SIGN LEGEND	NEW SIGNS "A"	NEW SIGNS "B"	EXISTING SIGNS RETAIN	EXISTING SIGNS SALVAGE FROM	EXISTING SIGNS SALVAGE TO	EXISTING SIGNS REMOVE	EXIST POST RETAIN	EXIST POST REMOVE	NUMBER OF NEW POSTS	SQUARE STEEL (IN) 1.75 (LB/FT) 1.88	SQUARE STEEL (IN) 2.00 (LB/FT) 2.42	SQUARE STEEL (IN) 2.50 (LB/FT) 3.35	FOUNDATION	TUBULAR STEEL Ø (IN) 3.00 (LB/FT) 7.60	TUBULAR STEEL Ø (IN) 3.50 (LB/FT) 9.00	TUBULAR STEEL Ø (IN) 4.00 (LB/FT) 10.80	TUBULAR STEEL Ø (IN) 5.00 (LB/FT) 14.60	SIGN FRAME REQUIRED	REMARKS	SIGN DETAIL: DETAIL IN SHS	SIGN DETAIL: DETAIL ON SHEET NUMBER	SIGN DETAIL: DETAIL ON STD SHEET NUMBER
BLOOMFIELD VT 105							FY-FLUORESCENT YELLOW FYG-FLUORESCENT YELLOW GREEN																			"SHS"-STANDARD HIGHWAY SIGNS			
EB	0.000	C	VD-024	72	10		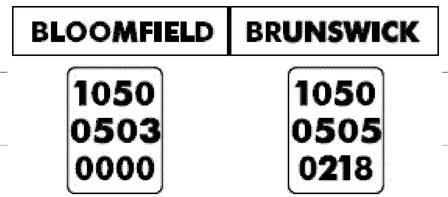	5.00								2		I2 I2 X							EXISTING SIGN IS WB (NORTH) SIDE OF RD. INSTALL NEW ON EB (SOUTH) SIDE OF ROAD		4	
		C	VD-700	6	10			0.42																				E-138
		C	VD-700	6	10			0.42																				E-138
EB	0.455	A	W1-2L	30	30		LEFT CURVE						1		X													
		A	W13-1	18	18		35 MPH PLAQUE						1															
EB	0.505	A	W11-6H	30	30		SNOWMOBILE (FOLDING)						1		X													
EB	0.525	A	W1-2L	30	30			6.25								1		I5.3 X							INSTALL 100 FT +/- EAST OF EXIST SNOWMOBILE SIGN, 200 FT +/- WEST OF RR X-ING SIGN	X		
		A	W13-1	24	24			4.00																			X	
		A	W11-6H	30	30			6.25								1		I5.3 X							INSTALL ON SEPARATE POST TO THE RIGHT OF THE CURVE SIGN, IN CLOSED POSITION			E-153
EB	0.565	A	W10-1	36	36								1		X													
		A	W10-1	36	36			7.07								1		I3.8 X								X		
EB	0.620	A	W1-6	48	24								1		X													
		A	W1-6L	48	24	FY		8.00								2		I3.8 I3.8 X								X		
EB	0.660	B	W1-6	48	24																							
							SHEET TOTALS	37.41	0.00	0	0	0	5	0	0	7		~~105~~ 96										
								SF	SF	EA	EA	EA	EA	EA	EA	EA		FT										
							TOWN TOTALS	427.5	0.0	2.0	0.0	0.0	87	0.0	0.0	59		885.0										

SIGN SUMMARY SHEET

VERMONT AGENCY OF TRANSPORTATION

PROJECT NAME: **Derby-Bloomfield VT105**
PROJECT NUMBER: **STPG SIGN(22)**

FILE NAME: **Bloomfield.xls**
PROJECT MANAGER: **N. Avery**
DESIGNED BY: **M. Miller**
BLOOMFIELD SHEET 1

PLOT DATE: **6/11/2009**
DRAWN BY: **I. Shea**
CHECKED BY: **S. Menard**
SHEET **65** OF **79**