DIRECTION	MILEPOINT	LOCATION CODE (SHEET 2)	SIGN CODE	WIDTH (IN)	HEIGHT (IN)	SHEETING REMARKS	SIGN LEGEND	NEW SIGNS "A"	NEW SIGNS "B"	EXISTING SIGNS RETAIN	EXISTING SIGNS SALVAGE FROM	EXISTING SIGNS SALVAGE TO	EXISTING SIGNS REMOVE	EXIST POST RETAIN	EXIST POST REMOVE	NUMBER OF NEW POSTS	SQUARE STEEL (IN) 1.75 (LB / FT) 1.88	SQUARE STEEL (IN) 2.00 (LB / FT) 2.42	SQUARE STEEL (IN) 2.50 (LB / FT) 3.35	FOUNDATION	TUBULAR STEEL Ø (IN) 3.00 (LB / FT) 7.60	TUBULAR STEEL Ø (IN) 3.50 (LB / FT) 9.00	TUBULAR STEEL Ø (IN) 4.00 (LB / FT) 10.80	TUBULAR STEEL Ø (IN) 5.00 (LB / FT) 14.60	SIGN FRAME REQUIRED	REMARKS	SIGN DETAIL: DETAIL IN SHS	SIGN DETAIL: DETAIL ON SHEET NUMBER	SIGN DETAIL: DETAIL ON STD SHEET NUMBER
BLOOMFIELD VT 105							FY-FLUORESCENT YELLOW FYG-FLUORESCENT YELLOW GREEN																			"SHS"-STANDARD HIGHWAY SIGNS			
		A	M1-5	30	24								1															
		A	M4-5	24	12								1															
		A	M1-4	24	24								1															
		A	M4-6	24	12			2.00								1		14 X							#1A	GREEN ON WHITE SHEETING	X	7	
		A	M1-5	30	24			5.00																				E-136B
		A	M4-5	24	12			2.00																		BLACK ON WHITE SHEETING	X		
		A	M1-4	24	24			4.00																		BLACK ON WHITE SHEETING	X		
EB	4.260	A	VR-040	24	24		THROUGH WAY ENDS						1		X													
		B	VR-041	24	24		THROUGH WAY BEGINS						1															
		A	VR-038	24	18								1															
		B	VR-039	24	18		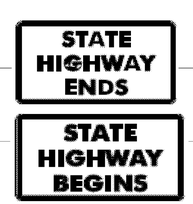																					
		A	VR-038	24	18			3.00								1		12.5 X								INSTALL SIGNS BACK TO BACK			E-141
		B	VR-039	24	18			3.00																				E-141
WB	4.26	F	D1-1A	72	10								1	X														
		F	D1-1A	72	10								1															
							SHEET TOTALS	19.00	0.00	0	0	0	8	0	0	2		~~30~~ 26.5										
								SF	SF	EA	EA	EA	EA	EA	EA	EA		FT										
							TOWN TOTALS	427.5	0.0	2.0	0.0	0.0	87	0.0	0.0	59		885.0										

SIGN SUMMARY SHEET

VERMONT AGENCY OF TRANSPORTATION

PROJECT NAME: Derby-Bloomfield VT105
PROJECT NUMBER: STPG SIGN(22)

FILE NAME: Bloomfield.xls
PROJECT MANAGER: N. Avery
DESIGNED BY: M. Miller
BLOOMFIELD SHEET 5

PLOT DATE: 6/11/2009
DRAWN BY: I. Shea
CHECKED BY: S. Menard