DIRECTION	MILEPOINT	LOCATION CODE (SHEET 2)	SIGN CODE	WIDTH (IN)	HEIGHT (IN)	SHEETING REMARKS	SIGN LEGEND	NEW SIGNS "A"	NEW SIGNS "B"	EXISTING SIGNS RETAIN	EXISTING SIGNS SALVAGE FROM	EXISTING SIGNS SALVAGE TO	EXISTING SIGNS REMOVE	EXIST POST RETAIN	EXIST POST REMOVE	NUMBER OF NEW POSTS	SQUARE STEEL (IN) 1.75 (LB/FT) 1.88	SQUARE STEEL (IN) 2.00 (LB/FT) 2.42	SQUARE STEEL (IN) 2.50 (LB/FT) 3.35	TUBULAR STEEL Ø (IN) FOUNDATION	TUBULAR STEEL Ø (IN) 3.00 (LB/FT) 7.60	TUBULAR STEEL Ø (IN) 3.50 (LB/FT) 9.00	TUBULAR STEEL Ø (IN) 4.00 (LB/FT) 10.80	TUBULAR STEEL Ø (IN) 5.00 (LB/FT) 14.60	SIGN FRAME REQUIRED	REMARKS	SIGN DETAIL: DETAIL IN SHS	SIGN DETAIL: DETAIL ON SHEET NUMBER	SIGN DETAIL: DETAIL ON STD SHEET NUMBER
BLOOMFIELD VT 105							FY-FLUORESCENT YELLOW FYG-FLUORESCENT YELLOW GREEN																			"SHS"-STANDARD HIGHWAY SIGNS			
		F	R2-1	24	30			5.00								1	13.5 X									X		
WB	4.000	F	VR-654	24	24								1		X														
		F	VR-655	24	18		STRICTLY ENFORCED				1		1																
		F	VR-654	24	24			4.00				1				1	14 X											E-143	
WB	3.960	F	VR-023B	24	30		$500 TRASH						1		X														
		F	VR-048	24	30			5.00								1	13.5 X											5	
WB	3.880	F	D1-1	72	10		ISLAND POND 16						1		X														
		F	D1-1	72	10		NEWPORT 40						1																
WB	3.860	F	VR-114	48	60								1		X														
		F	R2-1	24	30			5.00								1	16.5 X									X			
		F	VR-208	24	24			4.00																				5	
WB	3.700	F	D1-1	72	12		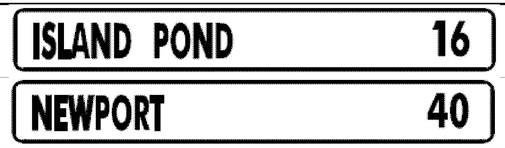	6.00								2	14 14.5 X										INSTALL ADJACENT TO BEGINNING OF WOODS		5	
		F	D1-1	72	12			6.00																				5	
WB	3.550	F	W1-2R	30	30			6.25								1	14.8 X										INSTALL 50 FT +/- WEST OF DRIVEWAYS			
WB	3.440	F	W1-2R	30	30		RIGHT CURVE						1		X														
SIGN SUMMARY SHEET							SHEET TOTALS	41.25 SF	0.00 SF	0 EA	~~0~~ EA	~~0~~ EA	7 EA	0 EA	0 EA	7 EA	~~105~~ 100.8 FT												
VERMONT AGENCY OF TRANSPORTATION							TOWN TOTALS	427.5	0.0	2.0	0.0	0.0	87	0.0	0.0	59	885.0											

PROJECT NAME: **Derby-Bloomfield VT105**
PROJECT NUMBER: **STPG SIGN(22)**

FILE NAME: **Bloomfield.xls** PLOT DATE: **6/11/2009**
PROJECT MANAGER: **N. Avery** DRAWN BY: **I. Shea**
DESIGNED BY: **M. Miller** CHECKED BY: **S. Menard**
BLOOMFIELD SHEET 10 SHEET **74** OF **79**