DIRECTION	MILEPOINT	LOCATION CODE (SHEET 2)	SIGN CODE	WIDTH (IN)	HEIGHT (IN)	SHEETING REMARKS	SIGN LEGEND	NEW SIGNS "A"	NEW SIGNS "B"	EXISTING SIGNS RETAIN	EXISTING SIGNS SALVAGE FROM	EXISTING SIGNS SALVAGE TO	EXISTING SIGNS REMOVE	EXIST POST RETAIN	EXIST POST REMOVE	NUMBER OF NEW POSTS	SQUARE STEEL (IN) (LB / FT) 1.75 / 1.88	SQUARE STEEL (IN) (LB / FT) 2.00 / 2.42	SQUARE STEEL (IN) (LB / FT) 2.50 / 3.35	TUBULAR STEEL Ø (IN) FOUNDATION	TUBULAR STEEL Ø (IN) (LB / FT) 3.00 / 7.60	TUBULAR STEEL Ø (IN) (LB / FT) 3.50 / 9.00	TUBULAR STEEL Ø (IN) (LB / FT) 4.00 / 10.80	TUBULAR STEEL Ø (IN) (LB / FT) 5.00 / 14.60	SIGN FRAME REQUIRED	REMARKS	SIGN DETAIL: DETAIL IN SHS	SIGN DETAIL: DETAIL ON SHEET NUMBER	SIGN DETAIL: DETAIL ON STD SHEET NUMBER
BLOOMFIELD VT 105							FY-FLUORESCENT YELLOW FYG-FLUORESCENT YELLOW GREEN																			"SHS"-STANDARD HIGHWAY SIGNS			
		F	W13-1	18	18		40 MPH PLAQUE						1															
WB	3.420	F	VW-054	30	30		HIDDEN DRIVE RIGHT						1		X													
WB	3.300	F	S3-1	30	30		SCHOOL BUS STOP AHEAD						1		X													
			W1-2R	30	30			6.25								1		14.5 X								X	
WB	2.310	F	VW-001	30	30								1		X													
WB	2.330	F	W7-3A	24	18		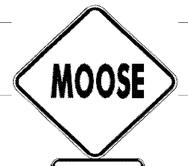						1															
WB	2.310	F	VW-001	30	30			6.25								1		15.5 X									6	
WB	2.330	F	W7-3A	24	18			3.00																		X		
WB	1.950	F	W1-2L	30	30								1		X													
WB	1.890	F	W1-2L	30	30	FY		6.25			SEE 4-25-11 D.R. SIGN NEEDED TO BE REMOVED AND RESET DUE TO DAMAGE					1		15.8 X							INSTALL 300 FT +/- WEST OF EXISTING	X		
WB	1.825	F	W1-6L	48	24		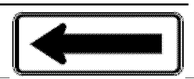						1		X													
		F	W1-6L	48	24	FY		8.00								2		13 13.3 X								X		
WB	1.815	E	W1-6R	48	24	FY		8.00								2		13 13.5 X							INSTALL ON WEST SIDE OF UTILITY POLE	X		
WB	1.690	G	VR-017	24	24								1		X													
		G	VR-017	24	30			5.00								1		15 X							TH-7, EAST BRANCH RD			E-141
SIGN SUMMARY SHEET							SHEET TOTALS	42.75 SF	0.00 SF	0 EA	1 ~~0~~ EA	1 ~~0~~ EA	9 ~~8~~ EA	1 ~~0~~ EA	1 ~~0~~ EA	9 ~~8~~ EA		~~120~~ 113.6 FT									
VERMONT AGENCY OF TRANSPORTATION							TOWN TOTALS	427.5	0.0	2.0	0.0	0.0	87	0.0	0.0	59		885.0									

PROJECT NAME: **Derby-Bloomfield VT105**
PROJECT NUMBER: **STPG SIGN(22)**
FILE NAME: **Bloomfield.xls**
PROJECT MANAGER: **N. Avery**
DESIGNED BY: **M. Miller**
BLOOMFIELD SHEET 11
PLOT DATE: **6/11/2009**
DRAWN BY: **I. Shea**
CHECKED BY: **S. Menard**
SHEET **75** OF **79**