DIR	MILEPOINT	LOCATION CODE (SHEET 2)	MUTCD CODE	WIDTH (IN)	HEIGHT (IN)	SHEETING REMARKS	SIGN LEGEND FOR ALL POST LENGTHS SEE ORIGINAL RECORD PLANS	NEW SIGNS "A"	NEW SIGNS "B"	EXISTING SIGNS RETAIN	EXISTING SIGNS SALVAGE FROM	EXISTING SIGNS SALVAGE TO	EXISTING SIGNS REMOVE	EXIST POST RETAIN	EXIST POST REMOVE	NUMBER OF NEW POSTS	SQUARE STEEL (in) 1.75 (LB / FT) 1.88	SQUARE STEEL (in) 2.00 (LB / FT) 2.42	SQUARE STEEL (in) 2.50 (LB / FT) 3.35	TUBULAR STEEL Ø (IN) FOUNDATION	TUBULAR STEEL Ø (IN) 3.00 (LB / FT) 7.60	TUBULAR STEEL Ø (IN) 3.50 (LB / FT) 9.00	TUBULAR STEEL Ø (IN) 4.00 (LB / FT) 10.80	TUBULAR STEEL Ø (IN) 5.00 (LB / FT) 14.60	SIGN FRAME REQUIRED	REMARKS	SIGN DETAIL: DETAIL IN SHS	SIGN DETAIL: DETAIL ON SHEET NUMBER	SIGN DETAIL: DETAIL ON STD SHEET NUMBER
BENSON VT22A							"FY"-FLUORESCENT YELLOW "FYG"-FLUORESCENT YELLOW GREEN																			"SHS"-STANDARD HIGHWAY SIGNS			
NB	1.400	A	W1-8	18	24		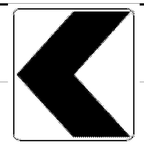						1		X														
		A	W1-8	18	24			3.00								1		X										X	
NB	1.401	B	W1-8	18	24		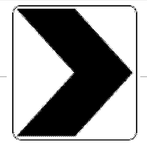						1		X														
		B	W1-8	18	24			3.00								1		X									INSTALL 5 FT ± NORTH OF NB-FACING CHEVRON. THIS CHEVRON FACES SOUTHBOUND TRAFFIC.	X	
NB	1.590	A	W1-2R	30	30			6.25								1		X									INSTALL 50 FT ± IN ADVANCE OF (SOUTH OF) "WATCH FOR TURNING VEHICLES" ASSEMBLY (TO BE REMOVED).	X	
NB	1.600	A	VW-205	48	48		WATCH FOR TURNING VEHICLES						1		X														
		A	W13-1	18	18		35 MPH (PLAQUE) 						1																
NB	1.633	A	VW-205	36	36			9.00								2		X									INSTALL 175 FT ± NORTH OF CURRENT SIGN POSITION		E-154
NB	2.210	A	VD-062B	72	16		BUSINESS SIGN			1				X															
		A	VD-062B	72	16		BUSINESS SIGN			1																			
		A	VD-062AS	72	16		BUSINESS SIGN			1																			
NB	2.259	A	VD-062B	72	16		BUSINESS SIGN			1																			
NB	2.414	A	W2-1	30	30		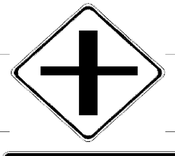						2		X														
		A	W2-1Mb	36	36			9.00								2		X											E-155
		A	W16-8A	48	15			5.00																			(LEFT ARROW) LAKE RD MILL POND RD (RIGHT ARROW)	6	
							SHEET TOTALS	35.25 SF	0.00 SF	4 EA	0 EA	0 EA	6 ~~5~~ EA	0 EA	0 EA	7 EA		105 FT								
							TOWN TOTALS	408.0	0.0	12.0	3.0	3.0	74	0.0	0.0	71		1065.0								

SIGN SUMMARY SHEET

VERMONT AGENCY OF TRANSPORTATION

PROJECT NAME: **Fair Haven-Panton VT 22A**
PROJECT NUMBER: **STPG SIGN(24)**

FILE NAME: **Benson.xls**
PROJECT MANAGER: **N. Averv**
DESIGNED BY: **M. Miller**
BENSON SHEET 3

PLOT DATE: **4/30/2009**
DRAWN BY: **I. Shea**
CHECKED BY: **S. Menard**