DIR	MILEPOINT	LOCATION CODE (SHEET 2)	MUTCD CODE	WIDTH (IN)	HEIGHT (IN)	SHEETING REMARKS	SIGN LEGEND FOR ALL POST LENGTHS SEE ORIGINAL RECORD PLANS	NEW SIGNS "A"	NEW SIGNS "B"	EXISTING SIGNS RETAIN	EXISTING SIGNS SALVAGE FROM	EXISTING SIGNS SALVAGE TO	EXISTING SIGNS REMOVE	EXIST POST RETAIN	EXIST POST REMOVE	NUMBER OF NEW POSTS	SQUARE STEEL (in) 1.75 (LB / FT) 1.88	SQUARE STEEL (in) 2.00 (LB / FT) 2.42	SQUARE STEEL (in) 2.50 (LB / FT) 3.35	TUBULAR STEEL Ø (IN) FOUNDATION	TUBULAR STEEL Ø (IN) 3.00 (LB / FT) 7.60	TUBULAR STEEL Ø (IN) 3.50 (LB / FT) 9.00	TUBULAR STEEL Ø (IN) 4.00 (LB / FT) 10.80	TUBULAR STEEL Ø (IN) 5.00 (LB / FT) 14.60	SIGN FRAME REQUIRED	REMARKS	SIGN DETAIL DETAIL IN SHS	SIGN DETAIL DETAIL ON SHEET NUMBER	SIGN DETAIL DETAIL ON STD SHEET NUMBER
BENSON VT22A							"FY"-FLUORESCENT YELLOW "FYG"-FLUORESCENT YELLOW GREEN																			"SHS"-STANDARD HIGHWAY SIGNS			
		A	D1-1A	72	10		LAKE HORTONIA 5 --->						1																
		A	D1-1A	72	12			6.00								2		X								5	
NB	3.420	A	M3-2	24	12								1		X														
		A	M1-6	30	24								1																
		A	M6-1	21	15								1																
		A	M3-2	24	12			2.00								1		X								BLACK ON WHITE SHEETING	X	
		A	M1-6	30	24			5.00																				E-136C
		A	M6-1	21	15		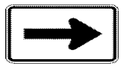	2.19																		BLACK ON WHITE SHEETING	X	
NB	3.419	C	VR-017	24	24								1		X												ROUTE 144 (TH-2)		
		C	VR-017	24	30			5.00								1		X										E-141
NB	3.427	D	R1-1	24	24																								
		D	R1-1	36	36			9.00								2		X								ROUTE 144 (TH-2). INSTALL AS CLOSE TO ACTUAL STOPPING POINT AS POSSIBLE.	X	
NB	3.487	A	M3-1	24	12			2.00								1		X								GREEN ON WHITE SHEETING. INSTALL BEHIND RAIL 315 FT ± NORTH OF ROUTE 144 JCT.	X	
		A	M1-5	30	24			5.00																				E-136B
NB	3.950	A	VD-091	24	30		PICNIC AREA AHEAD						2 ~~1~~		X														
							SHEET TOTALS	36.19 SF	0.00 SF	0 EA	0 EA	0 EA	~~7~~ 6 EA	0 EA	0 EA	7 EA		105 FT										
							TOWN TOTALS	408.0	0.0	12.0	3.0	3.0	74	0.0	0.0	71		1065.0										

SIGN SUMMARY SHEET

VERMONT AGENCY OF TRANSPORTATION

PROJECT NAME: **Fair Haven-Panton VT 22A**
PROJECT NUMBER: **STPG SIGN(24)**

FILE NAME: **Benson.xls**
PROJECT MANAGER: **N. Avery**
DESIGNED BY: **M. Miller**
BENSON SHEET 5

PLOT DATE: **4/30/2009**
DRAWN BY: **I. Shea**
CHECKED BY: **S. Menard**
SHEET **35** OF **117**