DIR	MILEPOINT	LOCATION CODE (SHEET 2)	MUTCD CODE	WIDTH (IN)	HEIGHT (IN)	SHEETING REMARKS	SIGN LEGEND FOR ALL POST LENGTHS SEE ORIGINAL RECORD PLANS	NEW SIGNS "A"	NEW SIGNS "B"	EXISTING SIGNS RETAIN	EXISTING SIGNS SALVAGE FROM	EXISTING SIGNS SALVAGE TO	EXISTING SIGNS REMOVE	EXIST POST RETAIN	EXIST POST REMOVE	NUMBER OF NEW POSTS	SQUARE STEEL (in) 1.75 (LB / FT) 1.88	SQUARE STEEL (in) 2.00 (LB / FT) 2.42	SQUARE STEEL (in) 2.50 (LB / FT) 3.35	TUBULAR STEEL Ø (IN) FOUNDATION	TUBULAR STEEL Ø (IN) 3.00 (LB / FT) 7.60	TUBULAR STEEL Ø (IN) 3.50 (LB / FT) 9.00	TUBULAR STEEL Ø (IN) 4.00 (LB / FT) 10.80	TUBULAR STEEL Ø (IN) 5.00 (LB / FT) 14.60	SIGN FRAME REQUIRED	REMARKS	SIGN DETAIL: DETAIL IN SHS	SIGN DETAIL: DETAIL ON SHEET NUMBER	SIGN DETAIL: DETAIL ON STD SHEET NUMBER
BENSON VT22A							"FY"-FLUORESCENT YELLOW "FYG"-FLUORESCENT YELLOW GREEN																			"SHS"-STANDARD HIGHWAY SIGNS			
SB	1.690	F	W1-8	18	24								1		X														
		F	W1-8	18	24			3.00								1		X										X	
SB	1.689	E	W1-8	18	24								1		X														
		E	W1-8	18	24			3.00								1		X									INSTALL 5 FT ± SOUTH OF SB-FACING CHEVRON. THIS CHEVRON FACES NORTHBOUND TRAFFIC	X	
SB	1.680	F	W1-8	18	24								1		X														
		F	W1-8	18	24			3.00								1		X										X	
SB	1.679	E	W1-8	18	24								1		X														
		E	W1-8	18	24			3.00								1		X									INSTALL 5 FT ± SOUTH OF SB-FACING CHEVRON. THIS CHEVRON FACES NORTHBOUND TRAFFIC	X	
SB	1.670	F	W1-8	18	24		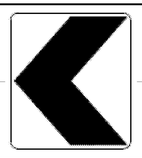						1		X														
		F	W1-8	18	24			3.00								1		X										X	
SB	1.669	E	W1-8	18	24		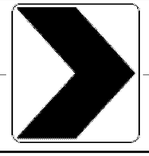						1		X														
		E	W1-8	18	24			3.00								1		X									INSTALL 5 FT ± SOUTH OF SB-FACING CHEVRON. THIS CHEVRON FACES NORTHBOUND TRAFFIC	X	
SB	1.475	F	W1-2R	30	30			6.25					2														INSTALL 125 FT ± NORTH OF FIELD DRIVE ON RIGHT. THERE IS A RESIDENTIAL DRIVE ACROSS FROM ± THIS POSITION.	X	
		F	W13-1	18	18			2.25																			X	
SB	1.030	F	W11-4	30	30										X											CATTLE SYMBOL ~ SIGN IS MISSING, EMPTY POST IS IN PLACE		
SIGN SUMMARY SHEET							SHEET TOTALS	26.50 SF	0.00 SF	0 EA	0 EA	0 EA	~~8~~ 6 EA	0 EA	0 EA	6 EA			90 FT									
VERMONT AGENCY OF TRANSPORTATION							TOWN TOTALS	408.0	0.0	12.0	3.0	3.0	74	0.0	0.0	71			1065.0									

PROJECT NAME: **Fair Haven-Panton VT 22A**
PROJECT NUMBER: **STPG SIGN(24)**

FILE NAME: **Benson.xls**
PROJECT MANAGER: **N. Avery**
DESIGNED BY: **M. Miller**
BENSON SHEET 12

PLOT DATE: **4/30/2009**
DRAWN BY: **I. Shea**
CHECKED BY: **S. Menard**