DIR	MILEPOINT	LOCATION CODE (SHEET 2)	MUTCD CODE	WIDTH (IN)	HEIGHT (IN)	SHEETING REMARKS	SIGN LEGEND	NEW SIGNS "A"	NEW SIGNS "B"	EXISTING SIGNS RETAIN	EXISTING SIGNS SALVAGE FROM	EXISTING SIGNS SALVAGE TO	EXISTING SIGNS REMOVE	EXIST POST RETAIN	EXIST POST REMOVE	NUMBER OF NEW POSTS	SQUARE STEEL (in) 1.75 (LB / FT) 1.88	SQUARE STEEL (in) 2.00 (LB / FT) 2.42	SQUARE STEEL (in) 2.50 (LB / FT) 3.35	TUBULAR STEEL Ø (IN) FOUNDATION	TUBULAR STEEL Ø (IN) 3.00 (LB / FT) 7.60	TUBULAR STEEL Ø (IN) 3.50 (LB / FT) 9.00	TUBULAR STEEL Ø (IN) 4.00 (LB / FT) 10.80	TUBULAR STEEL Ø (IN) 5.00 (LB / FT) 14.60	SIGN FRAME REQUIRED	REMARKS	SIGN DETAIL DETAIL IN SHS	SIGN DETAIL DETAIL ON SHEET NUMBER	SIGN DETAIL DETAIL ON STD SHEET NUMBER
ORWELL VT22A							"FY"-FLUORESCENT YELLOW "FYG"-FLUORESCENT YELLOW GREEN																			"SHS"-STANDARD HIGHWAY SIGNS			
NB	0.000	C	VD-024	60	7.5								2 ~~1~~		X														
		C	VD-025	60	7.5								1																
		C	VD-024	72	10			5.00								2		X										4	
		C	VD-025	72	10			5.00																				4	
		C	VD-700	6	10			0.42																					E-138
		C	VD-700	6	10			0.42																					E-138
NB	0.098	A	W1-2R	30	30								1		X														
		A	W13-1	18	18								1																
NB	0.160	A	W1-2R	30	30			6.25								1		X									INSTALL 325 FEET NORTH OF EXISTING LOCATION	X		
		A	W13-1	18	18			2.25																				X	
NB	1.200	A	W11-5	30	30			6.25								1		X									INSTALL 200 FEET NORTH OF DRIVE #117	X		
NB	1.780	A	VW-133	30	30			6.25								1		X									INSTALL 200 FEET SOUTH OF DRIVE #183			E-154
NB	2.290	A	VW-060	30	30		HIDDEN DRIVES						1		1														
NB	2.340	A	VW-133	30	30			6.25								1		X									INSTALL 350 FEET SOUTH OF DRIVE AT TOP OF THE HILL			E-154
NB	2.530	A	W2-1M	30	30								1		X														
							SHEET TOTALS	38.09 SF	0.00 SF	0 EA	0 EA	0 EA	~~6~~ 7 EA	0 EA	1 EA	6 EA		90 FT											
							TOWN TOTALS	339.7	0.0	9.0	3.0	3.0	67	0.0	2.0	38		570.0										

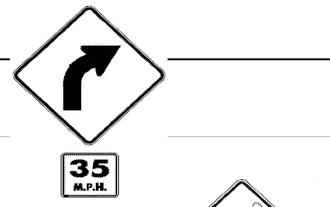

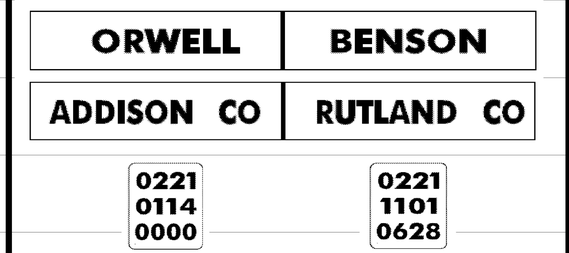

SIGN SUMMARY SHEET

VERMONT AGENCY OF TRANSPORTATION

PROJECT NAME: **Fair Haven-Panton VT22A**
PROJECT NUMBER: **STPG SIGN(24)**

FILE NAME: **Orwell.xls**
PROJECT MANAGER: **N. Avery**
DESIGNED BY: **J. Kelly**
ORWELL SHEET 1

PLOT DATE: **4/29/2009**
DRAWN BY: **I. Shea**
CHECKED BY: **S. Menard**
SHEET **44** OF **117**