DIR	MILEPOINT	LOCATION CODE (SHEET 2)	MUTCD CODE	WIDTH (IN)	HEIGHT (IN)	SHEETING REMARKS	SIGN LEGEND FOR ALL POST LENGTHS SEE ORIGINAL RECORD PLANS	NEW SIGNS "A"	NEW SIGNS "B"	EXISTING SIGNS RETAIN	EXISTING SIGNS SALVAGE FROM	EXISTING SIGNS SALVAGE TO	EXISTING SIGNS REMOVE	EXIST POST RETAIN	EXIST POST REMOVE	NUMBER OF NEW POSTS	SQUARE STEEL (in) 1.75 (LB / FT) 1.88	SQUARE STEEL (in) 2.00 (LB / FT) 2.42	SQUARE STEEL (in) 2.50 (LB / FT) 3.35	TUBULAR STEEL Ø (IN) FOUNDATION	TUBULAR STEEL Ø (IN) 3.00 (LB / FT) 7.60	TUBULAR STEEL Ø (IN) 3.50 (LB / FT) 9.00	TUBULAR STEEL Ø (IN) 4.00 (LB / FT) 10.80	TUBULAR STEEL Ø (IN) 5.00 (LB / FT) 14.60	SIGN FRAME REQUIRED	REMARKS	SIGN DETAIL DETAIL IN SHS	SIGN DETAIL DETAIL ON SHEET NUMBER	SIGN DETAIL DETAIL ON STD SHEET NUMBER
ORWELL VT22A							"FY"-FLUORESCENT YELLOW "FYG"-FLUORESCENT YELLOW GREEN																			"SHS"-STANDARD HIGHWAY SIGNS			
SB	2.780	F	W2-1M	30	30		CROSSROAD WARNING						1		X														
		F	S3-1	30	30		SCHOOL BUS STOP AHEAD						1		X														
		F	W13-1	18	18		40 MPH ADVISORY						1		X														
SB	2.730	F	W2-1Mb	30	30		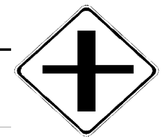	6.25					3			2		X										6
		F	W16-8a	48	15			5.00																		6
SB	2.652	G	VR-017	24	30								2		1											TH-27, COOK RD		
		G	VR-017	24	30			5.00								1		X										E-141
SB	2.644	H	R1-1	30	30							1	~~1~~		X											TH-27, COOK RD		
		H	R1-1	30	30			6.25								1		X									X	
SB	2.340	F	W11-5	30	30		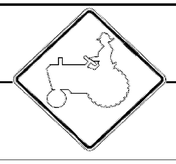	6.25								1		X								INSTALL DIRECTLY ACROSS FROM NEW HIDDEN DRIVE LEFT SIGN	X	
SB	1.920	F	W11-5	30	30		FARM MACHINERY						1		X														
		F	W16-2	24	18		NEXT 700 FEET						1																
SB	1.890	F	VW-054	30	30			6.25								1		X								INSTALL 150 FEET SOUTH OF EXISTING FARM MACHINERY 700 FEET ASSEMBLY		E-154
SB	0.356	F	W1-2L	30	30		LEFT CURVE WARNING						1		X														
		F	W13-1	18	18		35 MPH PLAQUE						1																
							SHEET TOTALS	35.00 SF	0.00 SF	0 EA	0 EA	0 EA	~~1~~ 0 EA	0 EA	1 EA	6 EA		90 FT										
							TOWN TOTALS	339.7	0.0	9.0	3.0	3.0	67	0.0	2.0	38		570.0										

SIGN SUMMARY SHEET

VERMONT AGENCY OF TRANSPORTATION

PROJECT NAME: **Fair Haven-Panton VT22A**
PROJECT NUMBER: **STPG SIGN(24)**

FILE NAME: **Orwell.xls**
PROJECT MANAGER: **N. Avery**
DESIGNED BY: **J. Kelly**
ORWELL SHEET 10

PLOT DATE: **4/29/2009**
DRAWN BY: **I. Shea**
CHECKED BY: **S. Menard**