DIR	MILEPOINT	LOCATION CODE (SHEET 2)	MUTCD CODE	WIDTH (IN)	HEIGHT (IN)	SHEETING REMARKS	SIGN LEGEND FOR ALL POST LENGTHS SEE ORIGINAL RECORD PLANS	NEW SIGNS "A"	NEW SIGNS "B"	EXISTING SIGNS RETAIN	EXISTING SIGNS SALVAGE FROM	EXISTING SIGNS SALVAGE TO	EXISTING SIGNS REMOVE	EXIST POST RETAIN	EXIST POST REMOVE	NUMBER OF NEW POSTS	SQUARE STEEL (in) 1.75 (LB / FT) 1.88	SQUARE STEEL (in) 2.00 (LB / FT) 2.42	SQUARE STEEL (in) 2.50 (LB / FT) 3.35	TUBULAR STEEL Ø (IN) FOUNDATION	TUBULAR STEEL Ø (IN) 3.00 (LB / FT) 7.60	TUBULAR STEEL Ø (IN) 3.50 (LB / FT) 9.00	TUBULAR STEEL Ø (IN) 4.00 (LB / FT) 10.80	TUBULAR STEEL Ø (IN) 5.00 (LB / FT) 14.60	SIGN FRAME REQUIRED	REMARKS	SIGN DETAIL DETAIL IN SHS	SIGN DETAIL DETAIL ON SHEET NUMBER	SIGN DETAIL DETAIL ON STD SHEET NUMBER
SHOREHAM VT22A							"FY"-FLUORESCENT YELLOW "FYG"-FLUORESCENT YELLOW GREEN																			"SHS"-STANDARD HIGHWAY SIGNS			
		A	VD-018	30	18			3.75								1		X									E-128A
NB	2.500	A	R2-1	24	30		SPEED LIMIT 40						1		X												
NB	2.520	A	R2-1	30	36			7.50								1		X								INSTALL 100 FEET NORTH OF EXISTING SPEED LIMIT 40		6	
NB	2.525	A	D1-1A	72	10		DESTINATION SIGN						1		X												
NB	2.553	A	W2-1Mb	30	30			6.25								1		X								INSTALL 150 FEET NORTH OF EXISTING WHITING D-BOARD		6	
NB	2.582	A	D1-1A	72	12		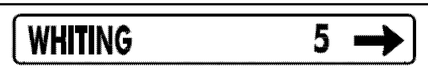	6.00								2		X								INSTALL 150 FEET SOUTH OF INTERSECTION		5	
NB	2.616	C	VR-017	24	30								1		X												RICHVILLE RD			
		C	VR-017	24	30			5.00								1		X								REMOVE ILLEGAL "NO THRU TRUCKS" SIGN			E-141
NB	2.616	D	R1-1	30	30								1		X												GATE POSTED - RICHVILLE RD			
		D	R1-1	30	30			6.25								1		X											
NB	2.624	D	R1-1	30	30							2	1		X												GATE POSTED - RICHVILLE RD			
		D	R1-1	30	30			6.25								1		X									X		
NB	2.642	A	M3-1	24	12								1		X															
		A	M1-5A	24	24								1																
		A	M3-1	24	12			2.00								1		X								GREEN ON WHITE SHEETING	X		
SIGN SUMMARY SHEET							SHEET TOTALS	43.00 SF	0.00 SF	0 EA	0 EA	2 ~~0~~ EA	7 EA	0 EA	0 EA	9 EA		135 FT										
VERMONT AGENCY OF TRANSPORTATION							TOWN TOTALS	569.3	0.0	6.0	2.0	2.0	132	1.0	0.0	77		1155.0										

PROJECT NAME: **Fair Haven-Panton VT22A**
PROJECT NUMBER: **STPG SIGN(24)**

FILE NAME: **Shoreham.xls**
PROJECT MANAGER: **N. Averv**
DESIGNED BY: **J. Kelly**
SHOREHAM SHEET 2

PLOT DATE: **4/29/2009**
DRAWN BY: **T. Guazzoni**
CHECKED BY: **S. Menard**
SHEET **56** OF **117**