DIR	MILEPOINT	LOCATION CODE (SHEET 2)	MUTCD CODE	WIDTH (IN)	HEIGHT (IN)	SHEETING REMARKS	SIGN LEGEND FOR ALL POST LENGTHS SEE ORIGINAL RECORD PLANS	NEW SIGNS "A"	NEW SIGNS "B"	EXISTING SIGNS RETAIN	EXISTING SIGNS SALVAGE FROM	EXISTING SIGNS SALVAGE TO	EXISTING SIGNS REMOVE	EXIST POST RETAIN	EXIST POST REMOVE	NUMBER OF NEW POSTS	SQUARE STEEL (in) 1.75 (LB / FT) 1.88	SQUARE STEEL (in) 2.00 (LB / FT) 2.42	SQUARE STEEL (in) 2.50 (LB / FT) 3.35	TUBULAR STEEL Ø (IN) FOUNDATION	TUBULAR STEEL Ø (IN) 3.00 (LB / FT) 7.60	TUBULAR STEEL Ø (IN) 3.50 (LB / FT) 9.00	TUBULAR STEEL Ø (IN) 4.00 (LB / FT) 10.80	TUBULAR STEEL Ø (IN) 5.00 (LB / FT) 14.60	SIGN FRAME REQUIRED	REMARKS	SIGN DETAIL DETAIL IN SHS	SIGN DETAIL DETAIL ON SHEET NUMBER	SIGN DETAIL DETAIL ON STD SHEET NUMBER
SHOREHAM VT22A							"FY"-FLUORESCENT YELLOW "FYG"-FLUORESCENT YELLOW GREEN																			"SHS"-STANDARD HIGHWAY SIGNS			
		F	M1-5	24	24		ROUTE 22A						1																
SB	3.285	F	VD-018	30	18		VILLAGE SIGN						1		X														
SB	3.215	F	M2-1	21	15								1		X														
		F	M1-5A	24	24								1																
		F	M2-1	21	15			2.19								1		X						GREEN WITH WHITE SHEETING	X		
		F	M1-5A	24	24			4.00																					E-136B
SB	3.175	F	D1-1A	72	10								1 1		X														
		F	D1-1A	72	10								1																
		F	D1-1G	72	10								1																
		F	D1-1M	72	10								1																
		F	D1-1A	72	12		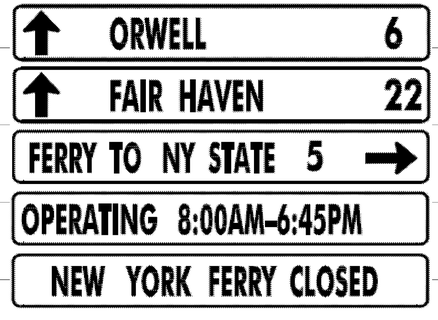	6.00								2		X								5	
		F	D1-1A	72	12			6.00																				5	
		F	D1-1M	72	12			6.00																				5	
		F	D1-1M	72	12			6.00																				5	
		F	D1-1M	72	12	TYPE IX		6.00																			Black on Orange sheeting. Do not install sign. Supply to Colchester Traffic Shop		5	
							SHEET TOTALS	36.19 SF	0.00 SF	0 EA	0 EA	0 EA	9 8 EA	0 EA	0 EA	3 EA	45 FT								
							TOWN TOTALS	569.3	0.0	6.0	2.0	2.0	132	1.0	0.0	77	1155.0								

SIGN SUMMARY SHEET

VERMONT AGENCY OF TRANSPORTATION

PROJECT NAME: **Fair Haven-Panton VT22A**
PROJECT NUMBER: **STPG SIGN(24)**

FILE NAME: **Shoreham.xls**
PROJECT MANAGER: **N. Averv**
DESIGNED BY: **J. Kelly**
SHOREHAM SHEET 15

PLOT DATE: **4/29/2009**
DRAWN BY: **T. Guazzoni**
CHECKED BY: **S. Menard**
SHEET **69** OF **117**