DIR	MILEPOINT	LOCATION CODE (SHEET 2)	MUTCD CODE	WIDTH (IN)	HEIGHT (IN)	SHEETING REMARKS	SIGN LEGEND FOR ALL POST LENGTHS SEE ORIGINAL RECORD PLANS	NEW SIGNS "A"	NEW SIGNS "B"	EXISTING SIGNS RETAIN	EXISTING SIGNS SALVAGE FROM	EXISTING SIGNS SALVAGE TO	EXISTING SIGNS REMOVE	EXIST POST RETAIN	EXIST POST REMOVE	NUMBER OF NEW POSTS	SQUARE STEEL (in) 1.75 (LB / FT) 1.88	SQUARE STEEL (in) 2.00 (LB / FT) 2.42	SQUARE STEEL (in) 2.50 (LB / FT) 3.35	FOUNDATION	TUBULAR STEEL Ø (IN) 3.00 (LB / FT) 7.60	TUBULAR STEEL Ø (IN) 3.50 (LB / FT) 9.00	TUBULAR STEEL Ø (IN) 4.00 (LB / FT) 10.80	TUBULAR STEEL Ø (IN) 5.00 (LB / FT) 14.60	SIGN FRAME REQUIRED	REMARKS	SIGN DETAIL DETAIL IN SHS	SIGN DETAIL DETAIL ON SHEET NUMBER	SIGN DETAIL DETAIL ON STD SHEET NUMBER
BRIDPORT VT22A							"FY"-FLUORESCENT YELLOW "FYG"-FLUORESCENT YELLOW GREEN																			"SHS"-STANDARD HIGHWAY SIGNS			
		A	D1-1A	72	10								1																
		A	D1-1A	72	10								1																
		A	D1-1M	72	10								1																
			D1-1A	72	12		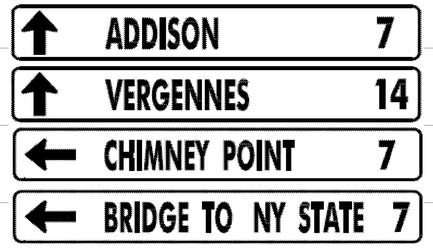	6.00							2		X									5	
			D1-1A	72	12			6.00																				5	
			D1-1A	72	12			6.00																				5	
			D1-1A	72	12			6.00																				5	
NB	3.765	A	M3-4S	24	12						1	1	1		X														
		A	M1-5	30	24								1																
		A	M6-1S	21	15								1																
		A	M3-1S	24	12								1																
		A	M1-5	24	24								1																
		A	M6-3S	21	15								1																
		A	M3-4S	24	12			2.00								2		X							#2A	GREEN ON WHITE SHEETING	X	7	
		A	M1-5	30	24			5.00																					E-136B
							SHEET TOTALS	31.00 SF	0.00 SF	0 EA	~~0~~ 1 EA	~~0~~ 1 EA	9 EA	0 EA	0 EA	4 EA		60 FT										
							TOWN TOTALS	750.3	0.0	11.0	0.0	0.0	175	0.0	0.0	115		1725.0										

SIGN SUMMARY SHEET

VERMONT AGENCY OF TRANSPORTATION

PROJECT NAME: Fair Haven-Panton VT22A
PROJECT NUMBER: STPG SIGN(24)

FILE NAME: Bridport.xls
PROJECT MANAGER: N. Avery
DESIGNED BY: J. Kelly
BRIDPORT SHEET 8

PLOT DATE: 4/29/2009
DRAWN BY: T. Guazzoni
CHECKED BY: S. Menard