DIR	MILEPOINT	LOCATION CODE (SHEET 2)	MUTCD CODE	WIDTH (IN)	HEIGHT (IN)	SHEETING REMARKS	SIGN LEGEND FOR ALL POST LENGTHS SEE ORIGINAL RECORD PLANS	NEW SIGNS "A"	NEW SIGNS "B"	EXISTING SIGNS RETAIN	EXISTING SIGNS SALVAGE FROM	EXISTING SIGNS SALVAGE TO	EXISTING SIGNS REMOVE	EXIST POST RETAIN	EXIST POST REMOVE	NUMBER OF NEW POSTS	SQUARE STEEL (in) 1.75 (LB / FT) 1.88	SQUARE STEEL (in) 2.00 (LB / FT) 2.42	SQUARE STEEL (in) 2.50 (LB / FT) 3.35	TUBULAR STEEL Ø (IN) FOUNDATION	TUBULAR STEEL Ø (IN) 3.00 (LB / FT) 7.60	TUBULAR STEEL Ø (IN) 3.50 (LB / FT) 9.00	TUBULAR STEEL Ø (IN) 4.00 (LB / FT) 10.80	TUBULAR STEEL Ø (IN) 5.00 (LB / FT) 14.60	SIGN FRAME REQUIRED	REMARKS	SIGN DETAIL DETAIL IN SHS	SIGN DETAIL DETAIL ON SHEET NUMBER	SIGN DETAIL DETAIL ON STD SHEET NUMBER
BRIDPORT VT22A							"FY"-FLUORESCENT YELLOW "FYG"-FLUORESCENT YELLOW GREEN																			"SHS"-STANDARD HIGHWAY SIGNS			
		A	M6-1S	21	15		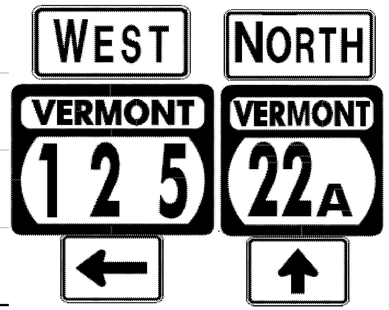	2.19																		GREEN ON WHITE SHEETING	X		
		A	M3-1S	24	12			2.00																		GREEN ON WHITE SHEETING	X		
		A	M1-5	24	24			4.00																					E-136B
		A	M6-3S	21	15			2.19																		GREEN ON WHITE SHEETING	X		
NB	3.775	C	W1-7	48	24								1		X														
		C	W1-7	48	24			8.00								2		X									X		
NB	3.784	C	VR-017	24	30								1		X														
		C	VR-017	24	30			5.00								1		X								TH-21 MARKET RD			E-141
NB	3.789	D	R1-1	30	30							2	1		X														
		D		30	30			6.25								1		X								TH-21 MARKET RD	X		
NB	3.830		D1-1A	72	12		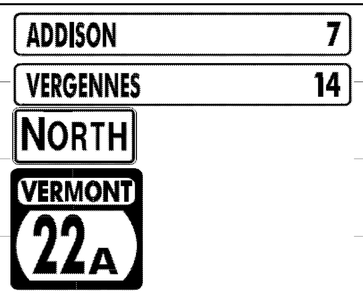	6.00								2		X										5	
			D1-1A	72	12			6.00																				5	
		A	M3-1	24	12			2.00																		GREEN ON WHITE SHEETING	X		
		A	M1-5	24	24			4.00																					E-136B
NB	3.870	A	M3-1S	24	12		NORTH						1		X														
							SHEET TOTALS	47.63 SF	0.00 SF	0 EA	0 EA	~~0~~ 2 EA	4 EA	0 EA	0 EA	6 EA		90 FT										
							TOWN TOTALS	750.3	0.0	11.0	0.0	0.0	175	0.0	0.0	115		1725.0											

SIGN SUMMARY SHEET

VERMONT AGENCY OF TRANSPORTATION

PROJECT NAME: **Fair Haven-Panton VT22A**
PROJECT NUMBER: **STPG SIGN(24)**

FILE NAME: **Bridport.xls**
PROJECT MANAGER: **N. Avery**
DESIGNED BY: **J. Kelly**
BRIDPORT SHEET 9

PLOT DATE: **4/29/2009**
DRAWN BY: **T. Guazzoni**
CHECKED BY: **S. Menard**
SHEET **82** OF **117**