DIR	MILEPOINT	LOCATION CODE (SHEET 2)	MUTCD CODE	WIDTH (IN)	HEIGHT (IN)	SHEETING REMARKS	SIGN LEGEND FOR ALL POST LENGTHS SEE ORIGINAL RECORD PLANS	NEW SIGNS "A"	NEW SIGNS "B"	EXISTING SIGNS RETAIN	EXISTING SIGNS SALVAGE FROM	EXISTING SIGNS SALVAGE TO	EXISTING SIGNS REMOVE	EXIST POST RETAIN	EXIST POST REMOVE	NUMBER OF NEW POSTS	SQUARE STEEL (in) (LB / FT) 1.75 / 1.88	SQUARE STEEL (in) (LB / FT) 2.00 / 2.42	SQUARE STEEL (in) (LB / FT) 2.50 / 3.35	TUBULAR STEEL Ø (IN) FOUNDATION	TUBULAR STEEL Ø (IN) (LB / FT) 3.00 / 7.60	TUBULAR STEEL Ø (IN) (LB / FT) 3.50 / 9.00	TUBULAR STEEL Ø (IN) (LB / FT) 4.00 / 10.80	TUBULAR STEEL Ø (IN) (LB / FT) 5.00 / 14.60	SIGN FRAME REQUIRED	REMARKS	SIGN DETAIL: DETAIL IN SHS	SIGN DETAIL: DETAIL ON SHEET NUMBER	SIGN DETAIL: DETAIL ON STD SHEET NUMBER
ADDISON VT22A							"FY"-FLUORESCENT YELLOW "FYG"-FLUORESCENT YELLOW GREEN																			"SHS"-STANDARD HIGHWAY SIGNS			
SB	1.120	F	R2-1	24	30								1		X													
		F	R2-1	24	30			5.00								1		X									X	
SB	0.680	F	VW-054R	30	30								1		X													
		F	VW-054R	30	30			6.25								1		X										E-154
SB	0.495	F	W1-2L	30	30			6.25								1		X									X	
SB	0.140	F	W2-1	30	30		INTERSECTION WARNING						1		X													
SB	0.095	F	W1-2Ma R	30	30		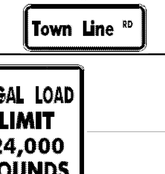	6.25					1			1		X								INSTALL 240 FT +/- SOUTH OF EXISTING CROSSROAD WARNING		6	
			W16-8	30	8			1.67																		Town Line RD IN UPPER AND LOWER CASE	X		
SB	0.004	G	VR-017	24	30								1		X												TH-24, TOWN LINE ROAD			
		G	VR-017	24	30			5.00								1		X										E-141

SIGN SUMMARY SHEET

VERMONT AGENCY OF TRANSPORTATION

SHEET TOTALS	30.42 SF	0.00 SF	0 EA	0 EA	0 EA	5 ~~4~~ EA	0 EA	0 EA	5 EA	75 FT					
TOWN TOTALS	357.4	0.0	58.0	0.0	0.0	69	1.0	0.0	56	840.0					

PROJECT NAME: **Fair Haven-Panton**
PROJECT NUMBER: **STPG SIGN(24)**

FILE NAME: **Addison.xls**
PROJECT MANAGER: **N. Avery**
DESIGNED BY: **M. Miller**
ADDISON SHEET 14

PLOT DATE: **4/29/2009**
DRAWN BY: **I. Shea**
CHECKED BY: **S. Menard**