DIR	MILEPOINT	LOCATION CODE (SHEET 2)	MUTCD CODE	WIDTH (IN)	HEIGHT (IN)	SHEETING REMARKS	SIGN LEGEND FOR ALL POST LENGTHS SEE ORIGINAL RECORD PLANS	NEW SIGNS "A"	NEW SIGNS "B"	EXISTING SIGNS RETAIN	EXISTING SIGNS SALVAGE FROM	EXISTING SIGNS SALVAGE TO	EXISTING SIGNS REMOVE	EXIST POST RETAIN	EXIST POST REMOVE	NUMBER OF NEW POSTS	SQUARE STEEL (in) 1.75 (LB / FT) 1.88	SQUARE STEEL (in) 2.00 (LB / FT) 2.42	SQUARE STEEL (in) 2.50 (LB / FT) 3.35	TUBULAR STEEL Ø (IN) FOUNDATION	TUBULAR STEEL Ø (IN) 3.00 (LB / FT) 7.60	TUBULAR STEEL Ø (IN) 3.50 (LB / FT) 9.00	TUBULAR STEEL Ø (IN) 4.00 (LB / FT) 10.80	TUBULAR STEEL Ø (IN) 5.00 (LB / FT) 14.60	SIGN FRAME REQUIRED	REMARKS	SIGN DETAIL DETAIL IN SHS	SIGN DETAIL DETAIL ON SHEET NUMBER	SIGN DETAIL DETAIL ON STD SHEET NUMBER
PANTON VT 22A							"FY"-FLUORESCENT YELLOW "FYG"-FLUORESCENT YELLOW GREEN																			"SHS"-STANDARD HIGHWAY SIGNS			
NB	0.000	C	VD-024	72	10		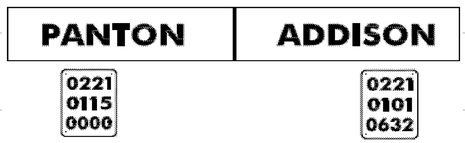	5.00					3			2		X									4	
		C	VD-700	6	10			0.42																				E-138
		C	VD-700	6	10			0.42																				E-138
NB	0.100	A	UNK										1		X											REMOVE TOWN'S WELCOME TO PANTON SIGN. NOT ALLOWED IN ROW.			
NB	0.950	A	VD-062B	72	16		BUSINESS SIGN			1				X														
NB	1.120	A	W2-2R	30	30		SIDE ROAD RIGHT						1		X														
NB	1.143	A	W2-2MaF	30	30			6.25								1		X								INSTALL 125 FT +/- NORTH OF EXISTING SIDE RD SIGN		6	
		A	W16-8	~~30~~ 24	~~12~~ 8			2.50																		East RD IN UPPER AND LOWER CASE	X		
NB	1.235	C	VR-017	24	30		LEGAL LOAD LIMIT 24,000 LBS				1				X														
		C	VR-017	24	30		LEGAL LOAD LIMIT 24,000 LBS					1				1		X								TH-17, EAST RD			E-141
NB	1.245	D	R1-1	30	30		STOP				1				X														
		D	R1-1	30	30		STOP					1				1		X								TH-17, EAST RD	X		
NB	1.310	A	VW-619	36	36								1		X														
		A	VW-619	36	36			9.00								2		X										6	
NB	2.570	A	R2-5	24	30		REDUCE SPEED AHEAD						1		X														
							SHEET TOTALS	23.59 SF	0.00 SF	1 EA	2 EA	2 EA	~~7~~ 4 EA	0 EA	0 EA	7 EA		105 FT										
							TOWN TOTALS	81.7	0.0	1.0	2.0	2.0	12	0.0	0.0	30		450.0										

SIGN SUMMARY SHEET

VERMONT AGENCY OF TRANSPORTATION

PROJECT NAME: **Fair Haven-Panton VT22A**
PROJECT NUMBER: **STPG SIGN(24)**

FILE NAME: **Panton.xls**
PROJECT MANAGER: **N. Averv**
DESIGNED BY: **A. Gamble**
PANTON SHEET 1

PLOT DATE: **4/30/2009**
DRAWN BY: **T. Guazzoni**
CHECKED BY: **S. Menard**
SHEET **112** OF **117**