DIRECTION	MILEPOINT	LOCATION CODE (SHEET 2)	SIGN CODE	WIDTH (IN)	HEIGHT (IN)	SHEETING REMARKS	SIGN LEGEND	NEW SIGNS "A"	NEW SIGNS "B"	EXISTING SIGNS RETAIN	EXISTING SIGNS SALVAGE FROM	EXISTING SIGNS SALVAGE TO	EXISTING SIGNS REMOVE	EXIST POST RETAIN	EXIST POST REMOVE	NUMBER OF NEW POSTS	SQUARE STEEL (IN) 1.75 (LB / FT) 1.88	SQUARE STEEL (IN) 2.00 (LB / FT) 2.42	SQUARE STEEL (IN) 2.50 (LB / FT) 3.35	FOUNDATION	TUBULAR STEEL Ø (IN) 3.00 (LB / FT) 7.60	TUBULAR STEEL Ø (IN) 3.50 (LB / FT) 9.00	TUBULAR STEEL Ø (IN) 4.00 (LB / FT) 10.80	TUBULAR STEEL Ø (IN) 5.00 (LB / FT) 14.60	SIGN FRAME REQUIRED	REMARKS	SIGN DETAIL: DETAIL IN SHS	SIGN DETAIL: DETAIL ON SHEET NUMBER	SIGN DETAIL: DETAIL ON STD SHEET NUMBER
HALIFAX		**VT 112**					FY-FLUORESCENT YELLOW FYG-FLUORESCENT YELLOW GREEN																			"SHS"-STANDARD HIGHWAY SIGNS		
		B	R8-3A	24	24			4.00																		INSTALLED ON BACK	X	
		B	R7-201A	12	6			0.50																		INSTALLED ON BACK	X	
NB	1.590	A	R8-3A	24	24								1		X													
		A	R7-201A	12	6								1															
		B	R8-3A	24	24								1															
		B	R7-201A	12	6								1															
		A	R8-3A	24	24			4.00								1		13.5 X									X	
		A	R7-201A	12	6			0.50																			X	
		B	R8-3A	24	24		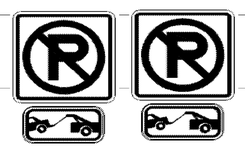	4.00																	INSTALLED ON BACK	X	
		B	R7-201A	12	6			0.50																	INSTALLED ON BACK	X	
NB	1.650	A	W1-2R	30	30		CURVE RIGHT						1		X													
NB	1.655	A	W1-2R	30	30	FY		6.25								1		16 X								INSTALL 25 FT ± NORTH OF PREVIOUS POSITION.	X	
NB	1.695	A	R8-3A	24	24								1		X													
		A	R7-201A	12	6								1															
		B	R8-3A	24	24								1															
							SHEET TOTALS	19.75	0.00	0	0	0	8	0	0	2		~~30~~ 29.5										
								SF	SF	EA	EA	EA	EA	EA	EA	EA		FT										
							TOWN TOTALS	640.7	0.0	5.0	10.0	10.0	176	0.0	0.0	111		1665.0										

SIGN SUMMARY SHEET

VERMONT AGENCY OF TRANSPORTATION

PROJECT NAME: **Halifax-Whitingham VT112**
PROJECT NUMBER: **STPG SIGN(26)**

FILE NAME: **Halifax.xls**
PROJECT MANAGER: **N. Averv**
DESIGNED BY: **M. Miller**
HALIFAX SHEET 6

PLOT DATE: **6/22/2009**
DRAWN BY: **I. Shea**
CHECKED BY: **S. Menard**
SHEET **13** OF **46**