DIRECTION	MILEPOINT	LOCATION CODE (SHEET 2)	SIGN CODE	WIDTH (IN)	HEIGHT (IN)	SHEETING REMARKS	SIGN LEGEND	NEW SIGNS "A"	NEW SIGNS "B"	EXISTING SIGNS RETAIN	EXISTING SIGNS SALVAGE FROM	EXISTING SIGNS SALVAGE TO	EXISTING SIGNS REMOVE	EXIST POST RETAIN	EXIST POST REMOVE	NUMBER OF NEW POSTS	SQUARE STEEL (IN) 1.75 (LB / FT) 1.88	SQUARE STEEL (IN) 2.00 (LB / FT) 2.42	SQUARE STEEL (IN) 2.50 (LB / FT) 3.35	FOUNDATION	TUBULAR STEEL Ø (IN) 3.00 (LB / FT) 7.60	TUBULAR STEEL Ø (IN) 3.50 (LB / FT) 9.00	TUBULAR STEEL Ø (IN) 4.00 (LB / FT) 10.80	TUBULAR STEEL Ø (IN) 5.00 (LB / FT) 14.60	SIGN FRAME REQUIRED	REMARKS	SIGN DETAIL: DETAIL IN SHS	SIGN DETAIL: DETAIL ON SHEET NUMBER	SIGN DETAIL: DETAIL ON STD SHEET NUMBER
HALIFAX VT 112							FY-FLUORESCENT YELLOW FYG-FLUORESCENT YELLOW GREEN																			"SHS"-STANDARD HIGHWAY SIGNS			
		A	W7-3A	24	18	FY	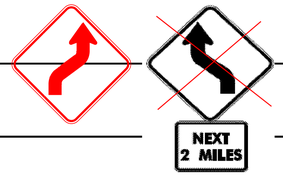	~~2.25~~ 3.00																		X		
NB	4.615	A	W1-2R	30	30		CURVE RIGHT						1		X													
NB	4.915	A	W1-2R	30	30		CURVE RIGHT						1		X													
NB	5.640	A	W1-5L	30	30		WINDING CURVES LEFT						1		X													
		A	W13-1	18	18		25 MPH PLAQUE						1															
NB	5.694	A	M2-1	21	15		JCT (BLACK ON WHITE)			1				X														
		A	M1-6	24	24		ROUTE 8A (BLACK ON WHITE)			1																		
NB	5.816	A	D1-1A	72	12		^UP JACKSONVILLE 2				1	1				2			~~18~~ 18.5 X								SALVAGE ALL SIGNS ON TO A NEW POST, IN THE SAME ORDER AS THE EXISTING ARRANGEMENT			
		A	D1-1A	72	12		^UP WILMINGTON 9				1	1														NOTE LARGER POSTS			
		A	D1-1M	72	12		<--- CHARLEMONT MASS				1	1																	
		A	M3-3	24	12		SOUTH				1	1																	
		A	M1-5A	24	24		ROUTE 8A				1	1																	
		A	M6-1	21	15		<--- LEFT				1	1																	
		A	M3-1S	24	12		NORTH				1	1																	
		A	M1-5	30	24		VERMONT 112				1	1																	
							SHEET TOTALS	~~2.25~~ 3.00	0.00	2	8	8	4	0	0	2			~~30~~ 36.5									
								SF	SF	EA	EA	EA	EA	EA	EA	EA			FT									
							TOWN TOTALS	640.7	0.0	5.0	10.0	10.0	176	0.0	0.0	111			1665.0									

SIGN SUMMARY SHEET

VERMONT AGENCY OF TRANSPORTATION

PROJECT NAME: **Halifax-Whitingham VT112**
PROJECT NUMBER: **STPG SIGN(26)**

FILE NAME: **Halifax.xls**
PROJECT MANAGER: **N. Averv**
DESIGNED BY: **M. Miller**
HALIFAX SHEET 14

PLOT DATE: **6/22/2009**
DRAWN BY: **I. Shea**
CHECKED BY: **S. Menard**
SHEET **21** OF **46**