DIRECTION	MILEPOINT	LOCATION CODE (SHEET 2)	SIGN CODE	WIDTH (IN)	HEIGHT (IN)	SHEETING REMARKS	SIGN LEGEND	NEW SIGNS "A"	NEW SIGNS "B"	EXISTING SIGNS RETAIN	EXISTING SIGNS SALVAGE FROM	EXISTING SIGNS SALVAGE TO	EXISTING SIGNS REMOVE	EXIST POST RETAIN	EXIST POST REMOVE	NUMBER OF NEW POSTS	SQUARE STEEL (IN) 1.75 (LB / FT) 1.88	SQUARE STEEL (IN) 2.00 (LB / FT) 2.42	SQUARE STEEL (IN) 2.50 (LB / FT) 3.35	TUBULAR STEEL Ø (IN) FOUNDATION	TUBULAR STEEL Ø (IN) 3.00 (LB / FT) 7.60	TUBULAR STEEL Ø (IN) 3.50 (LB / FT) 9.00	TUBULAR STEEL Ø (IN) 4.00 (LB / FT) 10.80	TUBULAR STEEL Ø (IN) 5.00 (LB / FT) 14.60	SIGN FRAME REQUIRED	REMARKS	SIGN DETAIL: DETAIL IN SHS	SIGN DETAIL: DETAIL ON SHEET NUMBER	SIGN DETAIL: DETAIL ON STD SHEET NUMBER
HALIFAX VT 112							FY-FLUORESCENT YELLOW FYG-FLUORESCENT YELLOW GREEN																			"SHS"-STANDARD HIGHWAY SIGNS			
		F	R7-201A	12	6								1																
		E	R8-3A	24	24								1																
		E	R7-201A	12	6								1																
		F	R8-3A	24	24		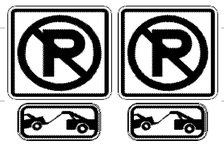	4.00								1		15 X								BEHIND RAIL	X	
		F	R7-201A	12	6			0.50																				X	
		E	R8-3A	24	24			4.00																			INSTALL BACK TO BACK	X	
		E	R7-201A	12	6			0.50																			INSTALL BACK TO BACK	X	
SB	1.395	F	R8-3A	24	24								1		X														
		F	R7-201A	12	6								1																
		E	R8-3A	24	24								1																
		E	R7-201A	12	6								1																
		F	R8-3A	24	24			4.00								1		13.5 X								BEHIND RAIL	X	
		F	R7-201A	12	6		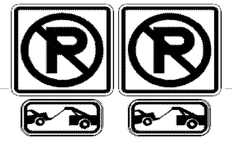	0.50																			MM. PLAQUE ALSO	X	
		E	R8-3A	24	24			4.00																			INSTALL BACK TO BACK	X	
		E	R7-201A	12	6		1120 1308 0140	0.50																			INSTALL BACK TO BACK	X	
SIGN SUMMARY SHEET							SHEET TOTALS	18.00 SF	0.00 SF	0 EA	0 EA	0 EA	7 EA	0 EA	0 EA	2 EA	~~30~~ 28.5 FT											
VERMONT AGENCY OF TRANSPORTATION							TOWN TOTALS	640.7	0.0	5.0	10.0	10.0	176	0.0	0.0	111	1665.0											

PROJECT NAME: **Halifax-Whitingham VT112**
PROJECT NUMBER: **STPG SIGN(26)**

FILE NAME: **Halifax.xls**
PROJECT MANAGER: **N. Averv**
DESIGNED BY: **M. Miller**
HALIFAX SHEET 22

PLOT DATE: **6/22/2009**
DRAWN BY: **I. Shea**
CHECKED BY: **S. Menard**
SHEET **29** OF **46**