DIRECTION	MILEPOINT	LOCATION CODE (SHEET 2)	SIGN CODE	WIDTH (IN)	HEIGHT (IN)	SHEETING REMARKS	SIGN LEGEND	NEW SIGNS "A"	NEW SIGNS "B"	EXISTING SIGNS RETAIN	EXISTING SIGNS SALVAGE FROM	EXISTING SIGNS SALVAGE TO	EXISTING SIGNS REMOVE	EXIST POST RETAIN	EXIST POST REMOVE	NUMBER OF NEW POSTS	SQUARE STEEL (IN) (LB / FT) 1.75 / 1.88	SQUARE STEEL (IN) (LB / FT) 2.00 / 2.42	SQUARE STEEL (IN) (LB / FT) 2.50 / 3.35	TUBULAR STEEL Ø (IN) FOUNDATION	TUBULAR STEEL Ø (IN) (LB / FT) 3.00 / 7.60	TUBULAR STEEL Ø (IN) (LB / FT) 3.50 / 9.00	TUBULAR STEEL Ø (IN) (LB / FT) 4.00 / 10.80	TUBULAR STEEL Ø (IN) (LB / FT) 5.00 / 14.60	SIGN FRAME REQUIRED	REMARKS	SIGN DETAIL: DETAIL IN SHS	SIGN DETAIL: DETAIL ON SHEET NUMBER	SIGN DETAIL: DETAIL ON STD SHEET NUMBER
WHITINGHAM VT 112							FY-FLUORESCENT YELLOW FYG-FLUORESCENT YELLOW GREEN																			"SHS"-STANDARD HIGHWAY SIGNS			
NB	0.005	A	W1-6	48	24								1		X													
		A	W1-6L	48	24		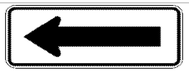	8.00								2		12.75 12.75 X								X	
NB	0.030	A	OM-3R	12	36			3.00• 3.00								1		10.5 X		IN LATE FALL 2009 THIS SIGN WAS INSTALLED AT FINAL INSPECTION IT WAS REPORTED MISSING AND HAD TO BE REPLACED.					INSTALL BEHIND RAIL AT SOUTHERLY ABUTMENT, AT "PINCH" POINT ± WHERE RAIL IS TANGENT AT SHOULDER.	X		
NB	0.055	C	W1-7	48	24		DOUBLE ARROW					1				2		14.25 13.75 X								RE-INSTALL TO 10 FT ± SOUTH OF LARGE ROUTE MARKER ASSEMBLY. PROVIDE 3 to 4 FEET OF SETBACK BEHIND RAIL, IF POSSIBLE.			
NB	0.057	C	D1-1A	72	12		<--- (45 DEG) JACKSONVILLE 2				1	1			X	2			14.5 14.5 X							NOTE LARGER SIZE SIGN POSTS			
		C	D1-1A	72	12		<--- (45 DEG) WILMINGTON 9				1	1														PROVIDE BETTER SETBACK FROM FACE OF RAIL, IF POSSIBLE. 3 TO 4 FT WOULD BE IDEAL			
		C	D1-1M	72	12		GREENFIELD MASS --->				1	1																	
		C	M3-1	24	12		NORTH				1	1																	
		C	M1-5	30	24		VERMONT ROUTE 112				1	1																	
		C	M6-1	21	15		<--- LEFT				1	1																	
		C	M3-3	24	12		SOUTH				1	1																	
		C	M1-5	30	24		VERMONT ROUTE 112				1	1																	
		C	M6-1	21	15		RIGHT --->				1	1																	
NB	0.060	C	W1-7	48	24		DOUBLE ARROW				1				X												SEE NOTE AT NB 0.055 ABOVE			
NB	0.094	A	M3-1	24	12		NORTH			1				X															
							SHEET TOTALS	~~11.00~~ 14.00 SF	0.00 SF	1 EA	10 EA	10 EA	1 EA	0 EA	0 EA	7 EA	~~105~~ 93 FT											
							TOWN TOTALS	210.8 SF	0.0 SF	33.0 EA	18.0 EA	18.0 EA	47 EA	0.0 EA	0.0 EA	50 EA	750.0 FT											

SIGN SUMMARY SHEET

VERMONT AGENCY OF TRANSPORTATION

PROJECT NAME: **Halifax-Whitingham VT112**
PROJECT NUMBER: **STPG SIGN(26)**
FILE NAME: **Whitingham.xls**
PROJECT MANAGER: **N. Avery**
DESIGNED BY: **M. Miller**
PLOT DATE: **6/22/2009**
DRAWN BY: **I. Shea**
CHECKED BY: **S. Menard**
WHITINGHAM SHEET 1
SHEET **33** OF **46**