DIRECTION	MILEPOINT	LOCATION CODE (SHEET 2)	SIGN CODE	WIDTH (IN)	HEIGHT (IN)	SHEETING REMARKS	SIGN LEGEND	NEW SIGNS "A"	NEW SIGNS "B"	EXISTING SIGNS RETAIN	EXISTING SIGNS SALVAGE FROM	EXISTING SIGNS SALVAGE TO	EXISTING SIGNS REMOVE	EXIST POST RETAIN	EXIST POST REMOVE	NUMBER OF NEW POSTS	SQUARE STEEL (IN) (LB / FT) 1.75 / 1.88	SQUARE STEEL (IN) (LB / FT) 2.00 / 2.42	SQUARE STEEL (IN) (LB / FT) 2.50 / 3.35	TUBULAR STEEL Ø (IN) FOUNDATION	TUBULAR STEEL Ø (IN) (LB / FT) 3.00 / 7.60	TUBULAR STEEL Ø (IN) (LB / FT) 3.50 / 9.00	TUBULAR STEEL Ø (IN) (LB / FT) 4.00 / 10.80	TUBULAR STEEL Ø (IN) (LB / FT) 5.00 / 14.60	SIGN FRAME REQUIRED	REMARKS	SIGN DETAIL: DETAIL IN SHS	SIGN DETAIL: DETAIL ON SHEET NUMBER	SIGN DETAIL: DETAIL ON STD SHEET NUMBER
WHITINGHAM VT 112							FY-FLUORESCENT YELLOW FYG-FLUORESCENT YELLOW GREEN																			"SHS"-STANDARD HIGHWAY SIGNS			
		A	M1-5	30	24		VERMONT 112			1																		
NB	0.120	B	W1-6	48	24								1		X													
		B	W1-6R	48	24			8.00								2		12 13.25 X								IN NB LANE FACING SB TRAFFIC	X	
NB	0.138	A	W1-6	48	24								1		X													
		A	W1-6L	48	24		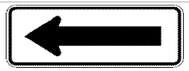	8.00								2		13.25 12.75 X								IN NB LANE FACING NB TRAFFIC	X	
NB	0.500	A	W1-2R	30	30		CURVE RIGHT			1				X														
NB	0.595	A	OM-3R	12	36								1		X												BR #13.		
		A	OM-3R	12	36			3.00								1		10.5 X								PROVIDE 4 FT OF VERTICAL CLEARANCE TO BOTTOM OF SIGN. BEHIND RAIL.	X	
NB	0.610	B	OM-3L	12	36								1		X												IN NB LANE FACING SB TRAFFIC.		
		B	OM-3L	12	36			3.00								1		10.5 X								PROVIDE 4 FT OF VERTICAL CLEARANCE TO BOTTOM OF SIGN. BEHIND RAIL.	X	
NB	0.848	A	W3-5	36	36		SPEED REDUCTION 40 MPH			1				X														
NB	0.916	A	VD-018A	30	18								1		X													
		A	VD-018A	30	18			3.75								1		13.25 X										E-128A
NB	0.956	A	R2-1	24	30		SPEED LIMIT 40			1				X														
NB	1.002	A	VD-062AS	72	16		BUSINESS SIGN			~~1~~				~~X~~	X											OLD POSTS WERE BENT. 2 NEW POSTS WERE INSTALLED.		
SIGN SUMMARY SHEET							SHEET TOTALS	25.75 SF	0.00 SF	5 EA	~~0~~ EA	~~0~~ EA	5 EA	0 EA	0 EA	7 EA			~~105~~ 115.5 FT									
VERMONT AGENCY OF TRANSPORTATION							TOWN TOTALS	210.8 SF	0.0 SF	33.0 EA	18.0 EA	18.0 EA	47 EA	0.0 EA	0.0 EA	50 EA			750.0 FT									

PROJECT NAME: **Halifax-Whitingham VT112**
PROJECT NUMBER: **STPG SIGN(26)**

FILE NAME: **Whitingham.xls** PLOT DATE: **6/22/2009**
PROJECT MANAGER: **N. Avery** DRAWN BY: **I. Shea**
DESIGNED BY: **M. Miller** CHECKED BY: **S. Menard**
WHITINGHAM SHEET 2 SHEET **34** OF **46**