DIRECTION	MILEPOINT	LOCATION CODE (SHEET 2)	SIGN CODE	WIDTH (IN)	HEIGHT (IN)	SHEETING REMARKS	SIGN LEGEND	NEW SIGNS "A"	NEW SIGNS "B"	EXISTING SIGNS RETAIN	EXISTING SIGNS SALVAGE FROM	EXISTING SIGNS SALVAGE TO	EXISTING SIGNS REMOVE	EXIST POST RETAIN	EXIST POST REMOVE	NUMBER OF NEW POSTS	SQUARE STEEL (IN) 1.75 (LB / FT) 1.88	SQUARE STEEL (IN) 2.00 (LB / FT) 2.42	SQUARE STEEL (IN) 2.50 (LB / FT) 3.35	FOUNDATION	TUBULAR STEEL Ø (IN) 3.00 (LB / FT) 7.60	TUBULAR STEEL Ø (IN) 3.50 (LB / FT) 9.00	TUBULAR STEEL Ø (IN) 4.00 (LB / FT) 10.80	TUBULAR STEEL Ø (IN) 5.00 (LB / FT) 14.60	SIGN FRAME REQUIRED	REMARKS	SIGN DETAIL: DETAIL IN SHS	SIGN DETAIL: DETAIL ON SHEET NUMBER	SIGN DETAIL: DETAIL ON STD SHEET NUMBER
WHITINGHAM VT 112							FY-FLUORESCENT YELLOW FYG-FLUORESCENT YELLOW GREEN																			"SHS"-STANDARD HIGHWAY SIGNS			
		F	M6-2	21	15								1															
		F	M3-3	24	12								1															
		F	M1-5	30	24								1															
		F	M6-3	21	15								1															
		F	M3-3	24	12		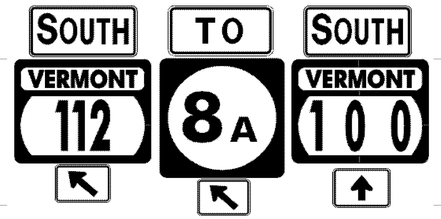	2.00														#3B	GREEN ON WHITE SHEETING.	X		
		F	M1-5	30	24			5.00																				E-136B
		F	M6-2	21	15			2.19																			GREEN ON WHITE SHEETING	X	
		F	M4-5	24	12			2.00																			BLACK ON WHITE SHEETING	X	
		F	M1-6	24	24			4.00																			BLACK ON WHITE SHEETING		E-136C
		F	M6-2	21	15			2.19																			BLACK ON WHITE SHEETING	X	
		F	M3-3	24	12			2.00																			GREEN ON WHITE SHEETING	X	
		F	M1-5	30	24			5.00																					E-136B
		F	M6-3	21	15			2.19																			GREEN ON WHITE SHEETING	X	
SB	1.598	E	R1-1	30	30								1		X												INSTALL SIMILAR TO EXISTING, 10 FT ± SOUTH OF ROUTE MARKER ASSEMBLY.			
		E	R1-1	30	30			6.25								1			13.25 X									
SIGN SUMMARY SHEET							SHEET TOTALS	32.82 SF	0.00 SF	0 EA	0 EA	0 EA	5 EA	0 EA	0 EA	1 EA	~~15~~ 13.25 FT											
VERMONT AGENCY OF TRANSPORTATION							TOWN TOTALS	210.8	0.0	33.0	18.0	18.0	47	0.0	0.0	50	750.0											

PROJECT NAME: **Halifax-Whitingham VT112**
PROJECT NUMBER: **STPG SIGN(26)**

FILE NAME: **Whitingham.xls**
PROJECT MANAGER: **N. Avery**
DESIGNED BY: **M. Miller**
WHITINGHAM SHEET 6

PLOT DATE: **6/22/2009**
DRAWN BY: **I. Shea**
CHECKED BY: **S. Menard**
SHEET **38** OF **46**