DIRECTION	MILEPOINT	LOCATION CODE (SHEET 2)	SIGN CODE	WIDTH (IN)	HEIGHT (IN)	SHEETING REMARKS	SIGN LEGEND	NEW SIGNS "A"	NEW SIGNS "B"	EXISTING SIGNS RETAIN	EXISTING SIGNS SALVAGE FROM	EXISTING SIGNS SALVAGE TO	EXISTING SIGNS REMOVE	EXIST POST RETAIN	EXIST POST REMOVE	NUMBER OF NEW POSTS	SQUARE STEEL (IN) 1.75 (LB / FT) 1.88	SQUARE STEEL (IN) 2.00 (LB / FT) 2.42	SQUARE STEEL (IN) 2.50 (LB / FT) 3.35	TUBULAR STEEL Ø (IN) FOUNDATION	TUBULAR STEEL Ø (IN) 3.00 (LB / FT) 7.60	TUBULAR STEEL Ø (IN) 3.50 (LB / FT) 9.00	TUBULAR STEEL Ø (IN) 4.00 (LB / FT) 10.80	TUBULAR STEEL Ø (IN) 5.00 (LB / FT) 14.60	SIGN FRAME REQUIRED	REMARKS	SIGN DETAIL: DETAIL IN SHS	SIGN DETAIL: DETAIL ON SHEET NUMBER	SIGN DETAIL: DETAIL ON STD SHEET NUMBER
WAITSFIELD VT 100							FY-FLUORESCENT YELLOW FYG-FLUORESCENT YELLOW GREEN																			"SHS"-STANDARD HIGHWAY SIGNS			
		F	OM-3R	12	36		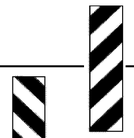	3.00								1		X								INSTALL AT 4 FT VERTICAL CLEARANCE	X		
SB	1.910	E	OM-3L	12	36								1		X													
		E	OM-3L	12	36			3.00								1		X								INSTALL AT 4 FT VERTICAL CLEARANCE	X		
SB	1.860	F	R2-1	24	30		SPEED LIMIT 50			1				X														
SB	1.200	F	VD-062B	72	16		BUSINESS SIGN			1				X														
SB	1.006	G	VR-017	24	30								1		X											KINGSBURY RD (TH-30)			
		G	VR-017	24	30			5.00								1		X										E-141
SB	0.998	H	R1-1	30	30								1		X											KINGSBURY RD (TH-30)			
		H	R1-1	30	30			6.25								1		X								REMOVE AND DISCARD INCORRECT MILE MARKER PLAQUE	X		
SB	0.970	F	W1-2R	30	30		CURVE RIGHT			1				X														
SB	0.677	F	W1-4R	30	30								1		X														
		F	W1-4R	30	30			6.25								1		X									X		
SB	0.570	F	VD-062AL	72	16		BUSINESS SIGN			1				X														
		F	VD-062AL	72	16		BUSINESS SIGN 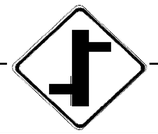			1																		
SB	0.455	F	W2-1Me	30	30			6.25								2		X		RESET TO SPEC. NEW POST.						INSTALL THIS ASSEMBLY ON 2 POSTS, THE INTESECTION WARNING SYMBOL ON TOP		7	
							SHEET TOTALS	29.75 SF	0.00 SF	5 EA	0 EA	0 EA	4 EA	0 EA	0 EA	7 EA		105 FT									
							TOWN TOTALS	684.6	0.0	99.0	18.0	18.0	141	0.0	0.0	129		1935.0									

SIGN SUMMARY SHEET

VERMONT AGENCY OF TRANSPORTATION

PROJECT NAME: **Ludlow-Waitsfield VT100**
PROJECT NUMBER: **STPG SIGN(27)**

FILE NAME: **Waitsfield.xls**
PROJECT MANAGER: **N. Avery**
DESIGNED BY: **M. Miller**
WAITSFIELD SHEET 27

PLOT DATE: **9/15/2009**
DRAWN BY: **I. Shea**
CHECKED BY: **N. Avery**