DIRECTION	MILEPOINT	LOCATION CODE (SHEET 2)	SIGN CODE	WIDTH (IN)	HEIGHT (IN)	SHEETING REMARKS	SIGN LEGEND	NEW SIGNS "A"	NEW SIGNS "B"	EXISTING SIGNS RETAIN	EXISTING SIGNS SALVAGE FROM	EXISTING SIGNS SALVAGE TO	EXISTING SIGNS REMOVE	EXIST POST RETAIN	EXIST POST REMOVE	NUMBER OF NEW POSTS	SQUARE STEEL (IN) 1.75 (LB / FT) 1.88	SQUARE STEEL (IN) 2.00 (LB / FT) 2.42	SQUARE STEEL (IN) 2.50 (LB / FT) 3.35	TUBULAR STEEL Ø (IN) FOUNDATION	TUBULAR STEEL Ø (IN) 3.00 (LB / FT) 7.60	TUBULAR STEEL Ø (IN) 3.50 (LB / FT) 9.00	TUBULAR STEEL Ø (IN) 4.00 (LB / FT) 10.80	TUBULAR STEEL Ø (IN) 5.00 (LB / FT) 14.60	SIGN FRAME REQUIRED	REMARKS	SIGN DETAIL: DETAIL IN SHS	SIGN DETAIL: DETAIL ON SHEET NUMBER	SIGN DETAIL: DETAIL ON STD SHEET NUMBER
MORETOWN VT 100							FY-FLUORESCENT YELLOW FYG-FLUORESCENT YELLOW GREEN																			"SHS"-STANDARD HIGHWAY SIGNS			
NB	0.000	C	VD-024	60	7.5								I		X													
		C	VD-024	72	10		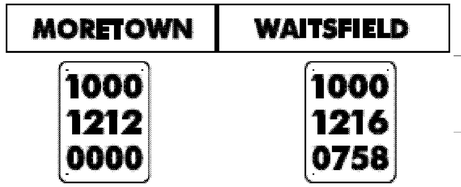	5.00								2		X									4
		C	VD-700	6	10			0.42																				
		C	VD-700	6	10			0.42																				
NB	0.187	A	VD-062B	72	16		BUSINESS SIGN			1				X														
		A	VD-062Al	72	16		BUSINESS SIGN			1																		
NB	0.230	A	M2-1S	21	15		JCT						1		X													
		A	M1-5	30	24		VT 100B						1															
NB	0.310	A	W2-2L	36	36		LEFT SIDE ROAD						1		X													
		A	W13-1	24	24		40 MPH PLAQUE						1															
		A	M2-1S	21	15			2.19								1		X						GREEN ON WHITE SHEETING	X	
		A	M1-5	30	24			5.00																				E-136B
NB	0.350	A	M3-1S	24	12		NORTH						1		X													
		A	M1-5	30	24		VERMONT 100						1															
		A	M5-1S	21	15		<--- LEFT (90 DEG)						1															
SIGN SUMMARY SHEET							SHEET TOTALS	13.03	0.00	2	0	0	7	0	0	3		45								
								SF	SF	EA	EA	EA	EA	EA	EA	EA		FT								
VERMONT AGENCY OF TRANSPORTATION							TOWN TOTALS	228.6	0.0	22.0	0.0	0.0	60	0.0	0.0	27		405.0								

PROJECT NAME: **Mortown-Newport Town VT100**
PROJECT NUMBER: **STPG SIGN(28)**

FILE NAME: **Moretown.xls** PLOT DATE: **9/16/2009**
PROJECT MANAGER: **N. Avery** DRAWN BY: **I. Shea**
DESIGNED BY: **D. Crossley** CHECKED BY: **J. Kelly**
MORETOWN SHEET 1 SHEET **9** OF **166**