DIRECTION	MILEPOINT	LOCATION CODE (SHEET 2)	SIGN CODE	WIDTH (IN)	HEIGHT (IN)	SHEETING REMARKS	SIGN LEGEND	NEW SIGNS "A"	NEW SIGNS "B"	EXISTING SIGNS RETAIN	EXISTING SIGNS SALVAGE FROM	EXISTING SIGNS SALVAGE TO	EXISTING SIGNS REMOVE	EXIST POST RETAIN	EXIST POST REMOVE	NUMBER OF NEW POSTS	SQUARE STEEL (IN) 1.75 (LB / FT) 1.88	SQUARE STEEL (IN) 2.00 (LB / FT) 2.42	SQUARE STEEL (IN) 2.50 (LB / FT) 3.35	TUBULAR STEEL Ø (IN) FOUNDATION	TUBULAR STEEL Ø (IN) 3.00 (LB / FT) 7.60	TUBULAR STEEL Ø (IN) 3.50 (LB / FT) 9.00	TUBULAR STEEL Ø (IN) 4.00 (LB / FT) 10.80	TUBULAR STEEL Ø (IN) 5.00 (LB / FT) 14.60	SIGN FRAME REQUIRED	REMARKS	SIGN DETAIL: DETAIL IN SHS	SIGN DETAIL: DETAIL ON SHEET NUMBER	SIGN DETAIL: DETAIL ON STD SHEET NUMBER
MORETOWN		**VT 100**					FY-FLUORESCENT YELLOW FYG-FLUORESCENT YELLOW GREEN																			"SHS"-STANDARD HIGHWAY SIGNS			
		A	M3-1S	24	12		NORTH						1															
		A	M1-5	30	24		VERMONT 100B						1															
		A	M6-3S	21	15		^UP ARROW						1															
		A	W2-2L	36	36		ELIMINATED	~~9.00~~			28.0		4			2		~~X~~		2				X			X	
	TYPE B ROUTE DIRECTIONAL SIGN ADDED PER C.O. #1	A	W16-8	36	12		ELIMINATED	~~3.00~~																			8	
NB	0.390	A	D2-1	72	10		^ MORETOWN 1						1		X													
		A	D2-1	72	10		^ MIDDLESEX 8						1															
		A	D1-1A	72	10		<--- WATERBURY 8						1															
		A	D1-1A	72	10		<--- STOWE 18						1															
	0.120	A	W3-5	36	36			9.00								2		X									X	
NB	0.410	A	R2-5A	24	30		REDUCED SPEED AHEAD						2 ~~1~~		X													
		A	D1-1A	72	12		MORETOWN 1	6.00								2			X								5	
		A	D1-1A	72	12		MIDDLESEX 8	6.00																			5	
		A	D1-1A	72	12		WATERBURY 8	6.00																			5	
		A	D1-1A	72	12		STOWE 18	6.00																			5	
							SHEET TOTALS	45.00 SF	0.00 SF	0 EA	0 EA	0 EA	8 EA	0 EA	0 EA	6 EA		90 FT										
							TOWN TOTALS	228.6	0.0	22.0	0.0	0.0	60	0.0	0.0	27		405.0										

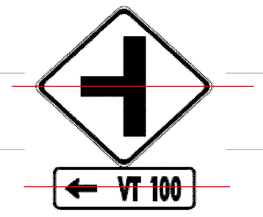

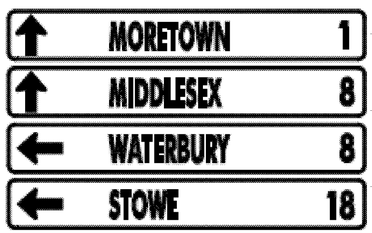

SIGN SUMMARY SHEET

VERMONT AGENCY OF TRANSPORTATION

PROJECT NAME: Mortown-Newport Town VT100
PROJECT NUMBER: STPG SIGN(28)

FILE NAME: Moretown.xls
PROJECT MANAGER: N. Avery
DESIGNED BY: D. Crossley
MORETOWN SHEET 2

PLOT DATE: 9/16/2009
DRAWN BY: I. Shea
CHECKED BY: J. Kelly