DIRECTION	MILEPOINT	LOCATION CODE (SHEET 2)	SIGN CODE	WIDTH (IN)	HEIGHT (IN)	SHEETING REMARKS	SIGN LEGEND	NEW SIGNS "A"	NEW SIGNS "B"	EXISTING SIGNS RETAIN	EXISTING SIGNS SALVAGE FROM	EXISTING SIGNS SALVAGE TO	EXISTING SIGNS REMOVE	EXIST POST RETAIN	EXIST POST REMOVE	NUMBER OF NEW POSTS	SQUARE STEEL (IN) 1.75 (LB / FT) 1.88	SQUARE STEEL (IN) 2.00 (LB / FT) 2.42	SQUARE STEEL (IN) 2.50 (LB / FT) 3.35	TUBULAR STEEL Ø (IN) FOUNDATION	TUBULAR STEEL Ø (IN) 3.00 (LB / FT) 7.60	TUBULAR STEEL Ø (IN) 3.50 (LB / FT) 9.00	TUBULAR STEEL Ø (IN) 4.00 (LB / FT) 10.80	TUBULAR STEEL Ø (IN) 5.00 (LB / FT) 14.60	SIGN FRAME REQUIRED	REMARKS	SIGN DETAIL DETAIL IN SHS	SIGN DETAIL DETAIL ON SHEET NUMBER	SIGN DETAIL DETAIL ON STD SHEET NUMBER
WATERBURY VT 100							FY-FLUORESCENT YELLOW FYG-FLUORESCENT YELLOW GREEN																			"SHS"-STANDARD HIGHWAY SIGNS			
NB	0.011	K	R1-1	30	30								1		X													
		J	R4-7	24	30								1															
		J	OM1-1	18	18								1															
		K	R1-1	30	30		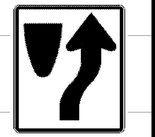	6.25								~~1~~		~~X~~							X		
		J	R4-7	24	30			5.00																		X		
		J	OM1-1	18	18		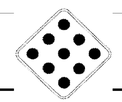	2.25																		X		
NB	0.067	A	VR-041	24	24		THROUGH WAY BEGINS HERE						1		X													
NB	0.078	A	VR-118L	30	48								1		X														
		A	VR-118L	30	48			10.00								2		X									6	
			SIGNS FROM MP 0.79 - MP 0.659 TO BE REPLACED IN STOWE STREET PART OF INTERSTATE SIGN PROJECT																									
NB	0.660	C	VR-017	24	24								1		X											STOWE ST TH -2			
		C	VR-017	24	30			5.00								1		X										E-141
NB	0.665	M	R10-12	24	30								1													ON SPAN WIRE			
		M	R10-12	24	30			5.00																		ON SPAN WIRE	X		
NB	0.680	A	M3-1	24	12								1		X													
							SHEET TOTALS	33.50	0.00	0	0	0	8	0	0	4		60										
								SF	SF	EA	EA	EA	EA	EA	EA	EA		FT										
							TOWN TOTALS	622.8	0.0	89.0	5.0	5.0	115	2.0	0.0	105		1575.0										

SIGN SUMMARY SHEET

VERMONT AGENCY OF TRANSPORTATION

PROJECT NAME: Moretown-Newport Town VT100
PROJECT NUMBER: STPG SIGN(28)

FILE NAME: Waterbury.xls
PROJECT MANAGER: N. Avery
DESIGNED BY: D. Crossley
WATERBURY SHEET 1

PLOT DATE: 9/17/2009
DRAWN BY: I. Shea
CHECKED BY: N. Avery