DIRECTION	MILEPOINT	LOCATION CODE (SHEET 2)	SIGN CODE	WIDTH (IN)	HEIGHT (IN)	SHEETING REMARKS	SIGN LEGEND	NEW SIGNS "A"	NEW SIGNS "B"	EXISTING SIGNS RETAIN	EXISTING SIGNS SALVAGE FROM	EXISTING SIGNS SALVAGE TO	EXISTING SIGNS REMOVE	EXIST POST RETAIN	EXIST POST REMOVE	NUMBER OF NEW POSTS	SQUARE STEEL (IN) 1.75 (LB / FT) 1.88	SQUARE STEEL (IN) 2.00 (LB / FT) 2.42	SQUARE STEEL (IN) 2.50 (LB / FT) 3.35	TUBULAR STEEL Ø (IN) FOUNDATION	TUBULAR STEEL Ø (IN) 3.00 (LB / FT) 7.60	TUBULAR STEEL Ø (IN) 3.50 (LB / FT) 9.00	TUBULAR STEEL Ø (IN) 4.00 (LB / FT) 10.80	TUBULAR STEEL Ø (IN) 5.00 (LB / FT) 14.60	SIGN FRAME REQUIRED	REMARKS	SIGN DETAIL: DETAIL IN SHS	SIGN DETAIL: DETAIL ON SHEET NUMBER	SIGN DETAIL: DETAIL ON STD SHEET NUMBER
WATERBURY VT 100							FY-FLUORESCENT YELLOW FYG-FLUORESCENT YELLOW GREEN																			"SHS"-STANDARD HIGHWAY SIGNS			
NB	2.858	A	R2-1	24	30		SPEED LIMIT 40			1				X														
	NEW			30	30		END NO PASSING	6.25																				
		B	W14-3	48	36		NO PASSING ZONE			1																		
NB	3.088	A	VD-018	30	18					1				X														
		A	VD-018	30	18			3.75								1		X										E-128B
NB	3.120	A	VD-062BRN	72	16		BUSINESS SIGN			1				X														
		A	VD-062B	72	16		BUSINESS SIGN			1																		
		A	VD-062B	72	16		BUSINESS SIGN			1																		
NB	3.138	A	R2-1	24	30								1		X													
		A	R2-1	24	30			5.00								1		X									X	
NB	3.160	A	W2-1M f	36	36		MODIFIED CROSSROAD						1		X													
		A	W16-8A	48	15		<--- RESERVOIR RD HOWARD RD --->						1															
NB	3.210	A	W2-1M f	36	36		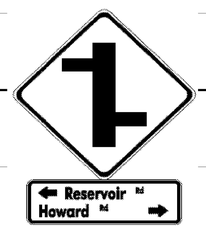	9.00								2		X								INSTALL 260' +/- NORTH OF ORIGINAL SIGN LOCATION		6	
			W16-8A	48	15			5.00																				8	
NB	3.324	C	VR-017	24	24									1	X													HOWARD AVE TH-1			
		C	VR-017	24	30			5.00								1		X											E-141
							SHEET TOTALS	27.75 SF	0.00 SF	6 EA	0 EA	0 EA	3 EA	1 EA	0 EA	5 EA		75 FT										
							TOWN TOTALS	622.8	0.0	89.0	5.0	5.0	115	2.0	0.0	105		1575.0										

SIGN SUMMARY SHEET

VERMONT AGENCY OF TRANSPORTATION

PROJECT NAME: **Moretown-Newport Town VT100**
PROJECT NUMBER: **STPG SIGN(28)**

FILE NAME: **Waterburv.xls**
PROJECT MANAGER: **N. Averv**
DESIGNED BY: **D. Crossley**
WATERBURY SHEET 7

PLOT DATE: **9/17/2009**
DRAWN BY: **I. Shea**
CHECKED BY: **N. Avery**