DIRECTION	MILEPOINT	LOCATION CODE (SHEET 2)	SIGN CODE	WIDTH (IN)	HEIGHT (IN)	SHEETING REMARKS	SIGN LEGEND	NEW SIGNS "A"	NEW SIGNS "B"	EXISTING SIGNS RETAIN	EXISTING SIGNS SALVAGE FROM	EXISTING SIGNS SALVAGE TO	EXISTING SIGNS REMOVE	EXIST POST RETAIN	EXIST POST REMOVE	NUMBER OF NEW POSTS	SQUARE STEEL (IN) (LB / FT) 1.75 / 1.88	SQUARE STEEL (IN) (LB / FT) 2.00 / 2.42	SQUARE STEEL (IN) (LB / FT) 2.50 / 3.35	FOUNDATION	TUBULAR STEEL Ø (IN) (LB / FT) 3.00 / 7.60	TUBULAR STEEL Ø (IN) (LB / FT) 3.50 / 9.00	TUBULAR STEEL Ø (IN) (LB / FT) 4.00 / 10.80	TUBULAR STEEL Ø (IN) (LB / FT) 5.00 / 14.60	SIGN FRAME REQUIRED	REMARKS	SIGN DETAIL: DETAIL IN SHS	SIGN DETAIL: DETAIL ON SHEET NUMBER	SIGN DETAIL: DETAIL ON STD SHEET NUMBER
STOWE VT 100							FY-FLUORESCENT YELLOW FYG-FLUORESCENT YELLOW GREEN																			"SHS"-STANDARD HIGHWAY SIGNS			
NB	4.920	A	W1-10R	30	30		MODIFIED RIGHT CURVE						1		X													
		A	VD-062B	72	16		BUSINESS SIGN					1				2		X								SALVAGE FROM NB 4.96		
		A	VD-062B	72	16		BUSINESS SIGN					1																
		A	VD-062B	72	16		BUSINESS SIGN					1																
NB	4.960	A	VD-062B	72	16		BUSINESS SIGN				1				X													
		A	VD-062B	72	16		BUSINESS SIGN				1																	
		A	VD-062B	72	16		BUSINESS SIGN				1																	
		A	W1-10 R	30	30	FY		6.25								1		X									X	
		A	W16-8	30	18	FY		3.75																				8
NB	5.005	A	VR-615	30	36								1		X													
		A	VR-615	30	36			7.50								1		X										7
NB	5.208	A	R2-1	24	30								1		X													
		A	R2-1	24	30			5.00								1		X									X	
NB	5.499	A	W2-2R	30	30		RIGHT SIDE ROAD						1		X													
NB	5.520	A	W2-2MaR	30	30			6.25								1		X								INSTALL 100' +/- NOTTH OF ORIGINAL SIGN LOCATION		6
							SHEET TOTALS	28.75	0.00	0	3	3	4	0	0	6		90										
								SF	SF	EA	EA	EA	EA	EA	EA	EA		FT										
							TOWN TOTALS	582.8	0.0	65.0	6.0	6.0	105	0.0	0.0	103		1545.0										

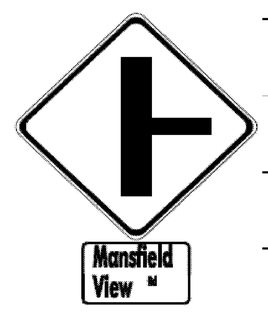

SIGN SUMMARY SHEET

VERMONT AGENCY OF TRANSPORTATION

PROJECT NAME: Moretown-Newport Town VT100
PROJECT NUMBER: STPG SIGN(28)

FILE NAME: Stowe.xls
PROJECT MANAGER: N. Avery
DESIGNED BY: D. Crosslev
STOWE SHEET 9

PLOT DATE: 9/29/2009
DRAWN BY: I. Shea
CHECKED BY: N. Avery