DIRECTION	MILEPOINT	LOCATION CODE (SHEET 2)	SIGN CODE	WIDTH (IN)	HEIGHT (IN)	SHEETING REMARKS	SIGN LEGEND	NEW SIGNS "A"	NEW SIGNS "B"	EXISTING SIGNS RETAIN	EXISTING SIGNS SALVAGE FROM	EXISTING SIGNS SALVAGE TO	EXISTING SIGNS REMOVE	EXIST POST RETAIN	EXIST POST REMOVE	NUMBER OF NEW POSTS	SQUARE STEEL (IN) 1.75 (LB / FT) 1.88	SQUARE STEEL (IN) 2.00 (LB / FT) 2.42	SQUARE STEEL (IN) 2.50 (LB / FT) 3.35	TUBULAR STEEL Ø (IN) FOUNDATION	TUBULAR STEEL Ø (IN) 3.00 (LB / FT) 7.60	TUBULAR STEEL Ø (IN) 3.50 (LB / FT) 9.00	TUBULAR STEEL Ø (IN) 4.00 (LB / FT) 10.80	TUBULAR STEEL Ø (IN) 5.00 (LB / FT) 14.60	SIGN FRAME REQUIRED	REMARKS	SIGN DETAIL: DETAIL IN SHS	SIGN DETAIL: DETAIL ON SHEET NUMBER	SIGN DETAIL: DETAIL ON STD SHEET NUMBER
EDEN VT 100							FY-FLUORESCENT YELLOW FYG-FLUORESCENT YELLOW GREEN																			"SHS"-STANDARD HIGHWAY SIGNS			
NB	6.805	A	W1-4R	30	30		RIGHT REVERSE CURVE			1				X														
NB	7.003	A	W1-6	48	24		<=== LEFT			1				X														
NB	7.003	B	W1-6	48	24		RIGHT ===>			1				X														
NB	7.030	A	W1-6	48	24		<=== LEFT			1					X	2		X										
NB	7.030	B	W1-6	48	24		RIGHT ===>			1				X		2		X										
NB	~~7.190~~ 7.292	B	W1-6	48	24		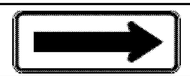	8.00								2		X									INSTALL SOUTH OF WOODS ROAD	X		
SB	7.292	F	W1-4R	30	30		RIGHT REVERSE CURVE						1		X														
		F	W1-2 R	30	30			6.25								1		X										X		
SB	5.336	F	W3-5	36	36								1		X														
		F	W3-5	36	36			9.00								2		X										X		
SB	5.254	F	R2-1	24	30								1		X														
		F	R2-1	30	36			7.50								1		X											6	
SB	5.197	F	W11-2	30	30	FYG	PEDESTRIAN			1				X														
		F	W16-4	30	24	FYG	NEXT 2000 FEET			1																		
SB	5.154	F	VW-060	30	30		HIDDEN DRIVES			1				X														
							SHEET TOTALS	30.75	0.00	8	0	0	3	0	0	8		120										
								SF	SF	EA	EA	EA	EA	EA	EA	EA		FT										
							TOWN TOTALS	462.5	0.0	40.0	2.0	2.0	86	0.0	0.0	77		1155.0										

SIGN SUMMARY SHEET

VERMONT AGENCY OF TRANSPORTATION

PROJECT NAME: **Moretown-Newport Town VT100**
PROJECT NUMBER: **STPG SIGN(28)**

FILE NAME: **Eden.xls** PLOT DATE: **9/30/2009**
PROJECT MANAGER: **N. Averv** DRAWN BY: **I. Shea**
DESIGNED BY: **D. Crosslev** CHECKED BY: **J. Kelly**
EDEN SHEET 8 SHEET **111** OF **166**