DIRECTION	MILEPOINT	LOCATION CODE (SHEET 2)	SIGN CODE	WIDTH (IN)	HEIGHT (IN)	SHEETING REMARKS	SIGN LEGEND	NEW SIGNS "A"	NEW SIGNS "B"	EXISTING SIGNS RETAIN	EXISTING SIGNS SALVAGE FROM	EXISTING SIGNS SALVAGE TO	EXISTING SIGNS REMOVE	EXIST POST RETAIN	EXIST POST REMOVE	NUMBER OF NEW POSTS	SQUARE STEEL (IN) 1.75 (LB / FT) 1.88	SQUARE STEEL (IN) 2.00 (LB / FT) 2.42	SQUARE STEEL (IN) 2.50 (LB / FT) 3.35	TUBULAR STEEL Ø (IN) FOUNDATION	TUBULAR STEEL Ø (IN) 3.00 (LB / FT) 7.60	TUBULAR STEEL Ø (IN) 3.50 (LB / FT) 9.00	TUBULAR STEEL Ø (IN) 4.00 (LB / FT) 10.80	TUBULAR STEEL Ø (IN) 5.00 (LB / FT) 14.60	SIGN FRAME REQUIRED	REMARKS	SIGN DETAIL: DETAIL IN SHS	SIGN DETAIL: DETAIL ON SHEET NUMBER	SIGN DETAIL: DETAIL ON STD SHEET NUMBER
EDEN VT 100							FY-FLUORESCENT YELLOW FYG-FLUORESCENT YELLOW GREEN																			"SHS"-STANDARD HIGHWAY SIGNS			
SB	2.808	F	W7-1	30	30		HILL						1		X														
SB	2.160	G	VR-017	24	30								1		X												DEUSO RD TH-15			
		G	VR-017	24	30			5.00								1		X											E-141
SB	2.151	H	R1-1	24	24								1		X												DEUSO RD TH-15			
		H	R1-1	30	30			6.25								1		X									X		
SB	2.070	F	S1-1YG	36	36		SCHOOL			1				X															
		F	W16-9YG	36	20		AHEAD			1																			
SB	1.985	F	D1-1E	72	12					1				X															
SB	1.941	G	VR-017	24	30								1		X												KNOWLES FLAT RD TH-13			
		G	VR-017	24	30			5.00								1		X											E-141
SB	1.932	H	R1-1	30	30								1		X												KNOWLES FLAT RD TH-13			
		H	R1-1	30	30			6.25								1		X									X		
SB	1.360	F	W2-2R	30	30		RIGHT SIDE ROAD (MOD.)						1		X															
SB	1.322	F	W2-2MaR	30	30		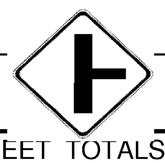	6.25								1		X									INSTALL 200' +/- SOUTH OF ORIGINAL SIGN LOCATION		6	
							SHEET TOTALS	28.75 SF	0.00 SF	3 EA	0 EA	0 EA	6 EA	0 EA	0 EA	5 EA	75 FT									
							TOWN TOTALS	462.5	0.0	40.0	2.0	2.0	86	0.0	0.0	77	1155.0									

SIGN SUMMARY SHEET

VERMONT AGENCY OF TRANSPORTATION

PROJECT NAME: **Moretown-Newport Town VT100**
PROJECT NUMBER: **STPG SIGN(28)**

FILE NAME: **Eden.xls**
PROJECT MANAGER: **N. Averv**
DESIGNED BY: **D. Crossley**
EDEN SHEET 14

PLOT DATE: **9/30/2009**
DRAWN BY: **I. Shea**
CHECKED BY: **J. Kelly**
SHEET **117** OF **166**