DIRECTION	MILEPOINT	LOCATION CODE (SHEET 2)	SIGN CODE	WIDTH (IN)	HEIGHT (IN)	SHEETING REMARKS	SIGN LEGEND	NEW SIGNS "A"	NEW SIGNS "B"	EXISTING SIGNS RETAIN	EXISTING SIGNS SALVAGE FROM	EXISTING SIGNS SALVAGE TO	EXISTING SIGNS REMOVE	EXIST POST RETAIN	EXIST POST REMOVE	NUMBER OF NEW POSTS	SQUARE STEEL (IN) 1.75 (LB / FT) 1.88	SQUARE STEEL (IN) 2.00 (LB / FT) 2.42	SQUARE STEEL (IN) 2.50 (LB / FT) 3.35	TUBULAR STEEL Ø (IN) FOUNDATION	TUBULAR STEEL Ø (IN) 3.00 (LB / FT) 7.60	TUBULAR STEEL Ø (IN) 3.50 (LB / FT) 9.00	TUBULAR STEEL Ø (IN) 4.00 (LB / FT) 10.80	TUBULAR STEEL Ø (IN) 5.00 (LB / FT) 14.60	SIGN FRAME REQUIRED	REMARKS	SIGN DETAIL: DETAIL IN SHS	SIGN DETAIL: DETAIL ON SHEET NUMBER	SIGN DETAIL: DETAIL ON STD SHEET NUMBER
TROY VT 100							FY-FLUORESCENT YELLOW FYG-FLUORESCENT YELLOW GREEN																			"SHS"-STANDARD HIGHWAY SIGNS			
NB	0.000	C	VD-024	60	7.5								1		X													
		C	VD-024	72	10		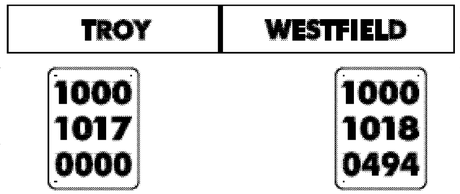	5.00								2 ~~1~~		X								4	
		C	VD-700	6	10			0.42																				E-138
		C	VD-700	6	10			0.42																				E-138
NB	0.004	A	VD-062AL	72	16		BUSINESS SIGN			1				X														
		A	VD-062AS	72	16		BUSINESS SIGN			1																		
		A	VD-062AL	72	16		BUSINESS SIGN			1																		
NB	0.110	A	R2-5A	24	30		REDUCED SPEED AHEAD						1		X														
		A	W3-5	36	36			9.00								2		X									X	
NB	0.150	A	VD-018	30	18								1		X													
		A	VD-018	30	18			3.75								1		X										E-128B
NB	0.190	A	M2-1	21	15		MISSING						~~1~~		~~X~~													
		A	M1-5	30	24								1															
		A	M2-1	21	15			2.19								1		X								GREEN ON WHITE SHEETING	X	
		A	M1-5	30	24			5.00																				E-136B
SIGN SUMMARY SHEET							SHEET TOTALS	25.78	0.00	3	0	0	5	0	0	5		75										
								SF	SF	EA	EA	EA	EA	EA	EA	EA		FT										
VERMONT AGENCY OF TRANSPORTATION							TOWN TOTALS	334.5	0.0	7.0	2.0	2.0	60	0.0	0.0	55		825.0										

PROJECT NAME: **Moretown-Newport Town VT100**
PROJECT NUMBER: **STPG SIGN(28)**

FILE NAME: **Trov.xls**
PROJECT MANAGER: **N. Averv**
DESIGNED BY: **D. Crossley**
TROY SHEET 1

PLOT DATE: **9/30/2009**
DRAWN BY: **I. Shea**
CHECKED BY: **J. Kelly**
SHEET **139** OF **166**