DIRECTION	MILEPOINT	LOCATION CODE (SHEET 2)	SIGN CODE	WIDTH (IN)	HEIGHT (IN)	SHEETING REMARKS	SIGN LEGEND	NEW SIGNS "A"	NEW SIGNS "B"	EXISTING SIGNS RETAIN	EXISTING SIGNS SALVAGE FROM	EXISTING SIGNS SALVAGE TO	EXISTING SIGNS REMOVE	EXIST POST RETAIN	EXIST POST REMOVE	NUMBER OF NEW POSTS	SQUARE STEEL (IN) 1.75 (LB / FT) 1.88	SQUARE STEEL (IN) 2.00 (LB / FT) 2.42	SQUARE STEEL (IN) 2.50 (LB / FT) 3.35	TUBULAR STEEL Ø (IN) FOUNDATION	TUBULAR STEEL Ø (IN) 3.00 (LB / FT) 7.60	TUBULAR STEEL Ø (IN) 3.50 (LB / FT) 9.00	TUBULAR STEEL Ø (IN) 4.00 (LB / FT) 10.80	TUBULAR STEEL Ø (IN) 5.00 (LB / FT) 14.60	SIGN FRAME REQUIRED	REMARKS	SIGN DETAIL: DETAIL IN SHS	SIGN DETAIL: DETAIL ON SHEET NUMBER	SIGN DETAIL: DETAIL ON STD SHEET NUMBER
TROY VT 100							FY-FLUORESCENT YELLOW FYG-FLUORESCENT YELLOW GREEN																			"SHS"-STANDARD HIGHWAY SIGNS			
SB	1.310	F	W1-6	48	24			8.00								2		X								INSTALL150 '+/- SOUTH OF LEFT REVERSE CURVE SIGN	X		
		E	W1-6	48	24		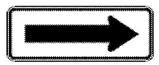	8.00								2		X									X		
SB	1.050	F	VD-062AL	72	16		BUSINESS SIGN			1				X															
		F	VD-062AS	72	16		BUSINESS SIGN			1																			
SB	0.960	F	R2-5A	24	30		REDUCED SPEED AHEAD						1		X														
		F	W3-5	36	36			9.00								2		X									X		
SB	0.850	F	VD-018	30	18								1		X														
		F	VD-018	30	18			3.75								1		X											E-128B
SB	0.850	F	OM-3R	12	36		OBJECT MARKER						1		X														
SB	0.820	E	OM-3R	12	36		OBJECT MARKER						1		X														
SB	0.810	F	R2-1	24	30								1		X														
		F	R2-1	30	36		DO NOT PLACE PER PROPERTY OWNER	~~7.50~~								~~1~~		~~X~~									6		
SB	0.734	G	VR-017	24	30								1		X												RIVER RD TH-22		
		G	VR-017	24	30			5.00								1		X											E-141
SB	0.726	H	R1-1	30	30								1		X												RIVER RD TH-22		
SIGN SUMMARY SHEET							SHEET TOTALS	41.25	0.00	2	0	0	7	0	0	9		135										
								SF	SF	EA	EA	EA	EA	EA	EA	EA		FT										
VERMONT AGENCY OF TRANSPORTATION							TOWN TOTALS	334.5	0.0	7.0	2.0	2.0	60	0.0	0.0	55		825.0										

PROJECT NAME: **Moretown-Newport Town VT100**
PROJECT NUMBER: **STPG SIGN(28)**

FILE NAME: **Troy.xls** PLOT DATE: **9/30/2009**
PROJECT MANAGER: **N. Avery** DRAWN BY: **I. Shea**
DESIGNED BY: **D. Crossley** CHECKED BY: **J. Kelly**
TROY SHEET 6 SHEET **144** OF **166**