Piece Schedule	
Piece	Weight (lbs)
AB1F1	52,040
AB1F2	52,990
AB1F3	58,520
AB1F4	58,520
WW-2	20,380
AB1S	53,300
AB1N	56,560
WW-1A	44,160
WW-1B	43,750
AB2F1	56,440
AB2F2	41,280
AB2F3	41,280
AB2F4	47,640
AB2F5	46,640
WW-3	38,600
AB2N	54,810
AB2S	53,290
WW-4A	32,700
WW-4B	31,850

Vermont Agency of Transportation

RECEIVED

Walden Footing Abutment Wingwall Submittal #2_CLB 4.21.15.pdf

CK'D BY CLB **OK'D BY** FDB

April 20, 2015

RESUBMIT NO **Approved**

BY C. CARLSON **DATE** 04/22/15

Abutment 1: Plan View

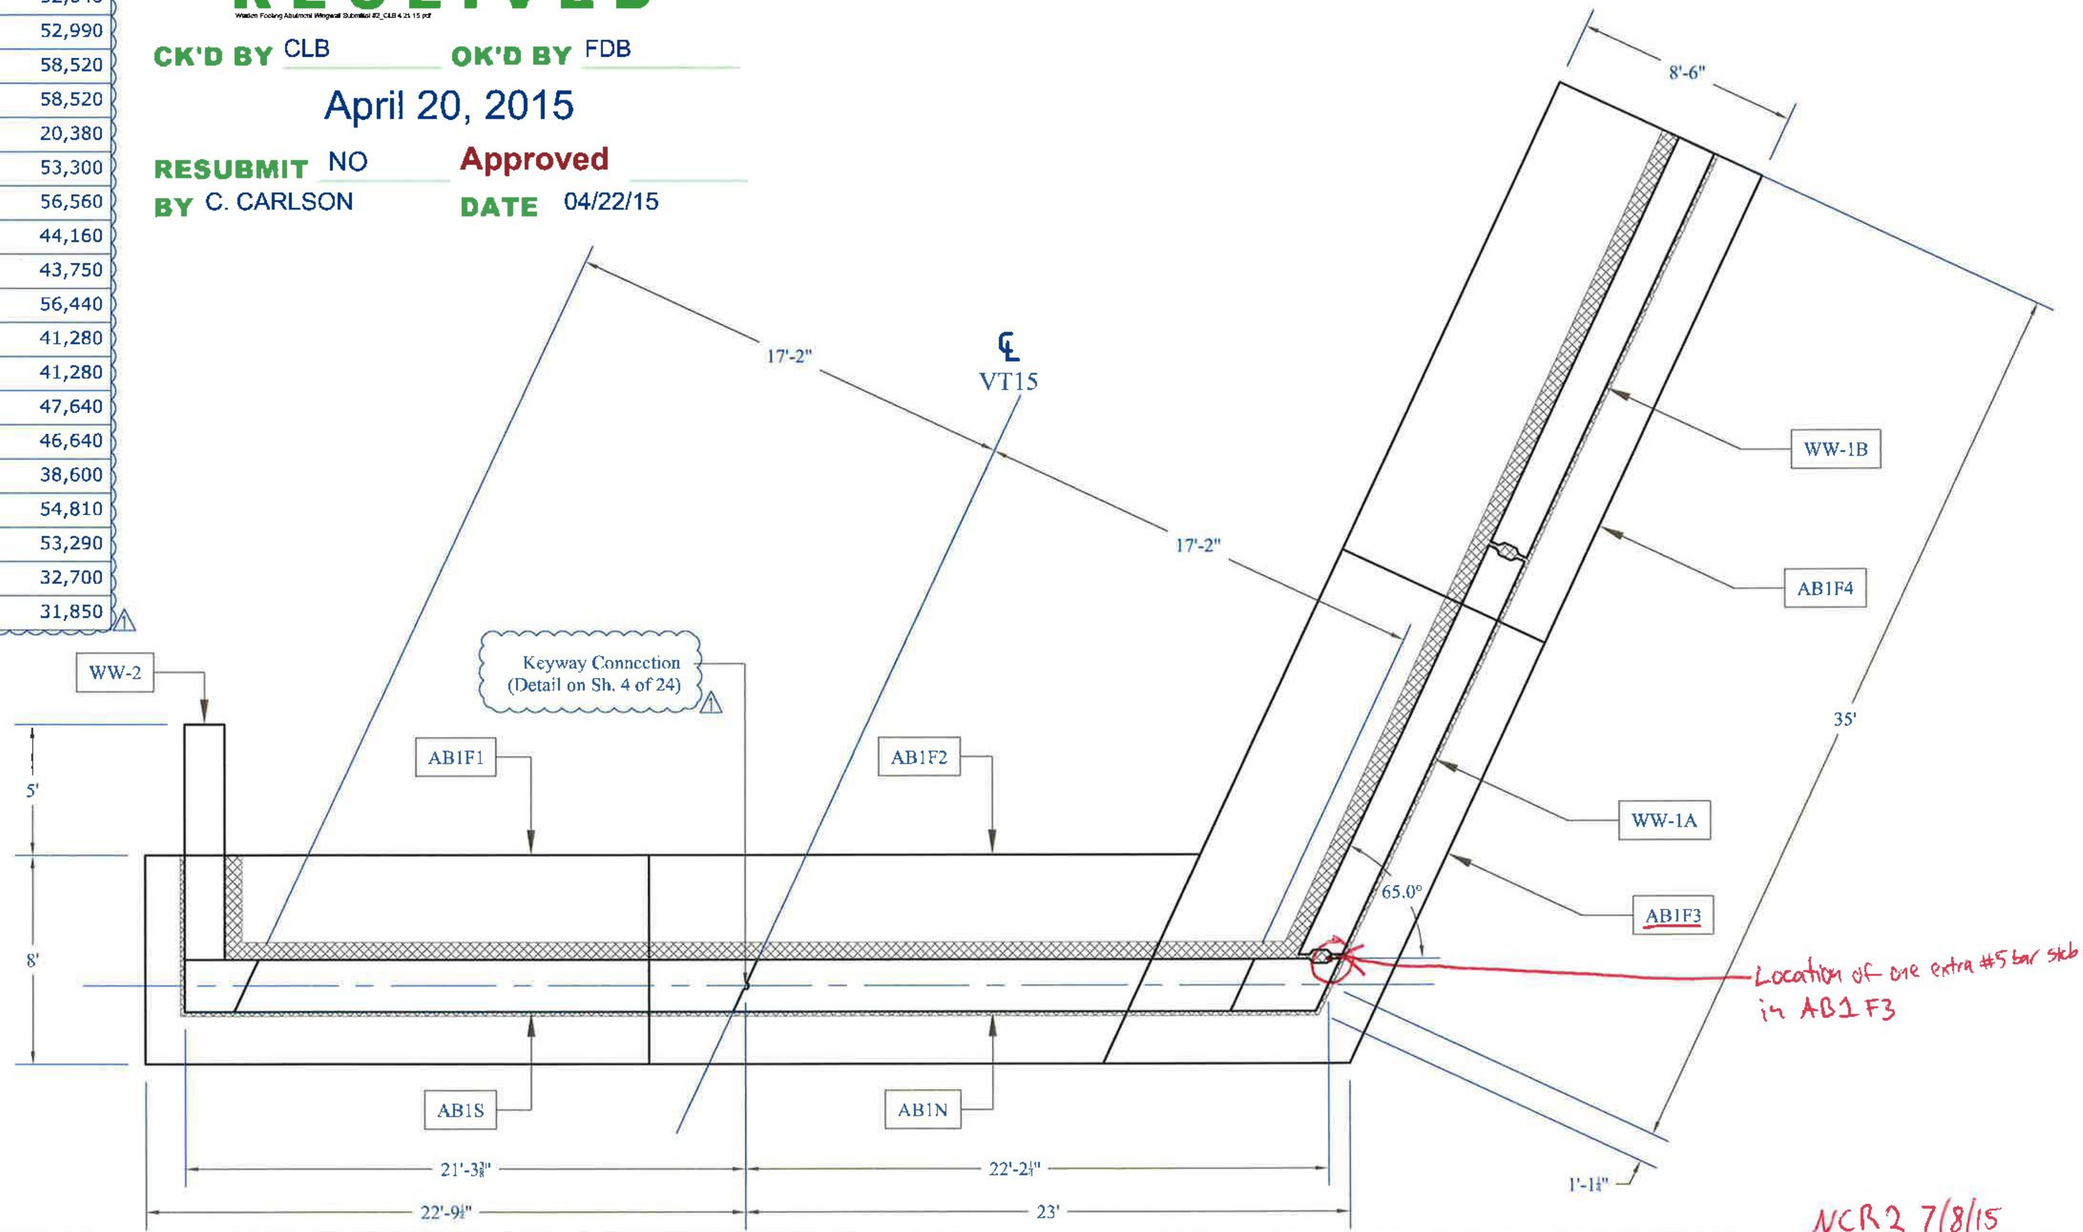

NCR2 7/8/15

CONTRACTORS VTSPE:	Rev.	Date	By	Description
	1	04/16/15	IBA	Changes per State Review

PRECAST CONCRETE ABUTMENT SHOP DRAWINGS (SDI JOB #15801)

SUPERVISOR: E. Barendse
DETAILER: I. ADAMS
CHECKER: E. Barendse
ENGINEER: VTAOT

PROJECT NAME: Walden BRF 030-3(5)
PROJECT #: 030-3(5)
LOCATION: Walden, VT

INSTALLER: J.A. McDonald, Inc. PO Box 132 Lyndon Center, VT 05850

FABRICATOR: 193 INDUSTRIAL AVE. WILLISTON, VT 05495 Ph: (802) 658-0201

SD Ireland PRECAST

04/08/15 | AB1_PLAN | 2_OF_25