Abutment Stem Keyway Detail

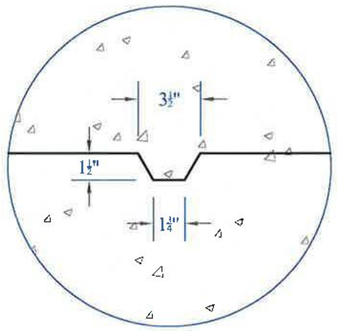

Vermont Agency of Transportation

RECEIVED

Walden Footing Abutments Wingwall Submittal 92_CLB 4.21.15.pdf

CK'D BY CLB **OK'D BY** FDB

April 20, 2015

RESUBMIT NO **Approved**

BY C. CARLSON **DATE** 04/22/15

Abutment 2: Plan View

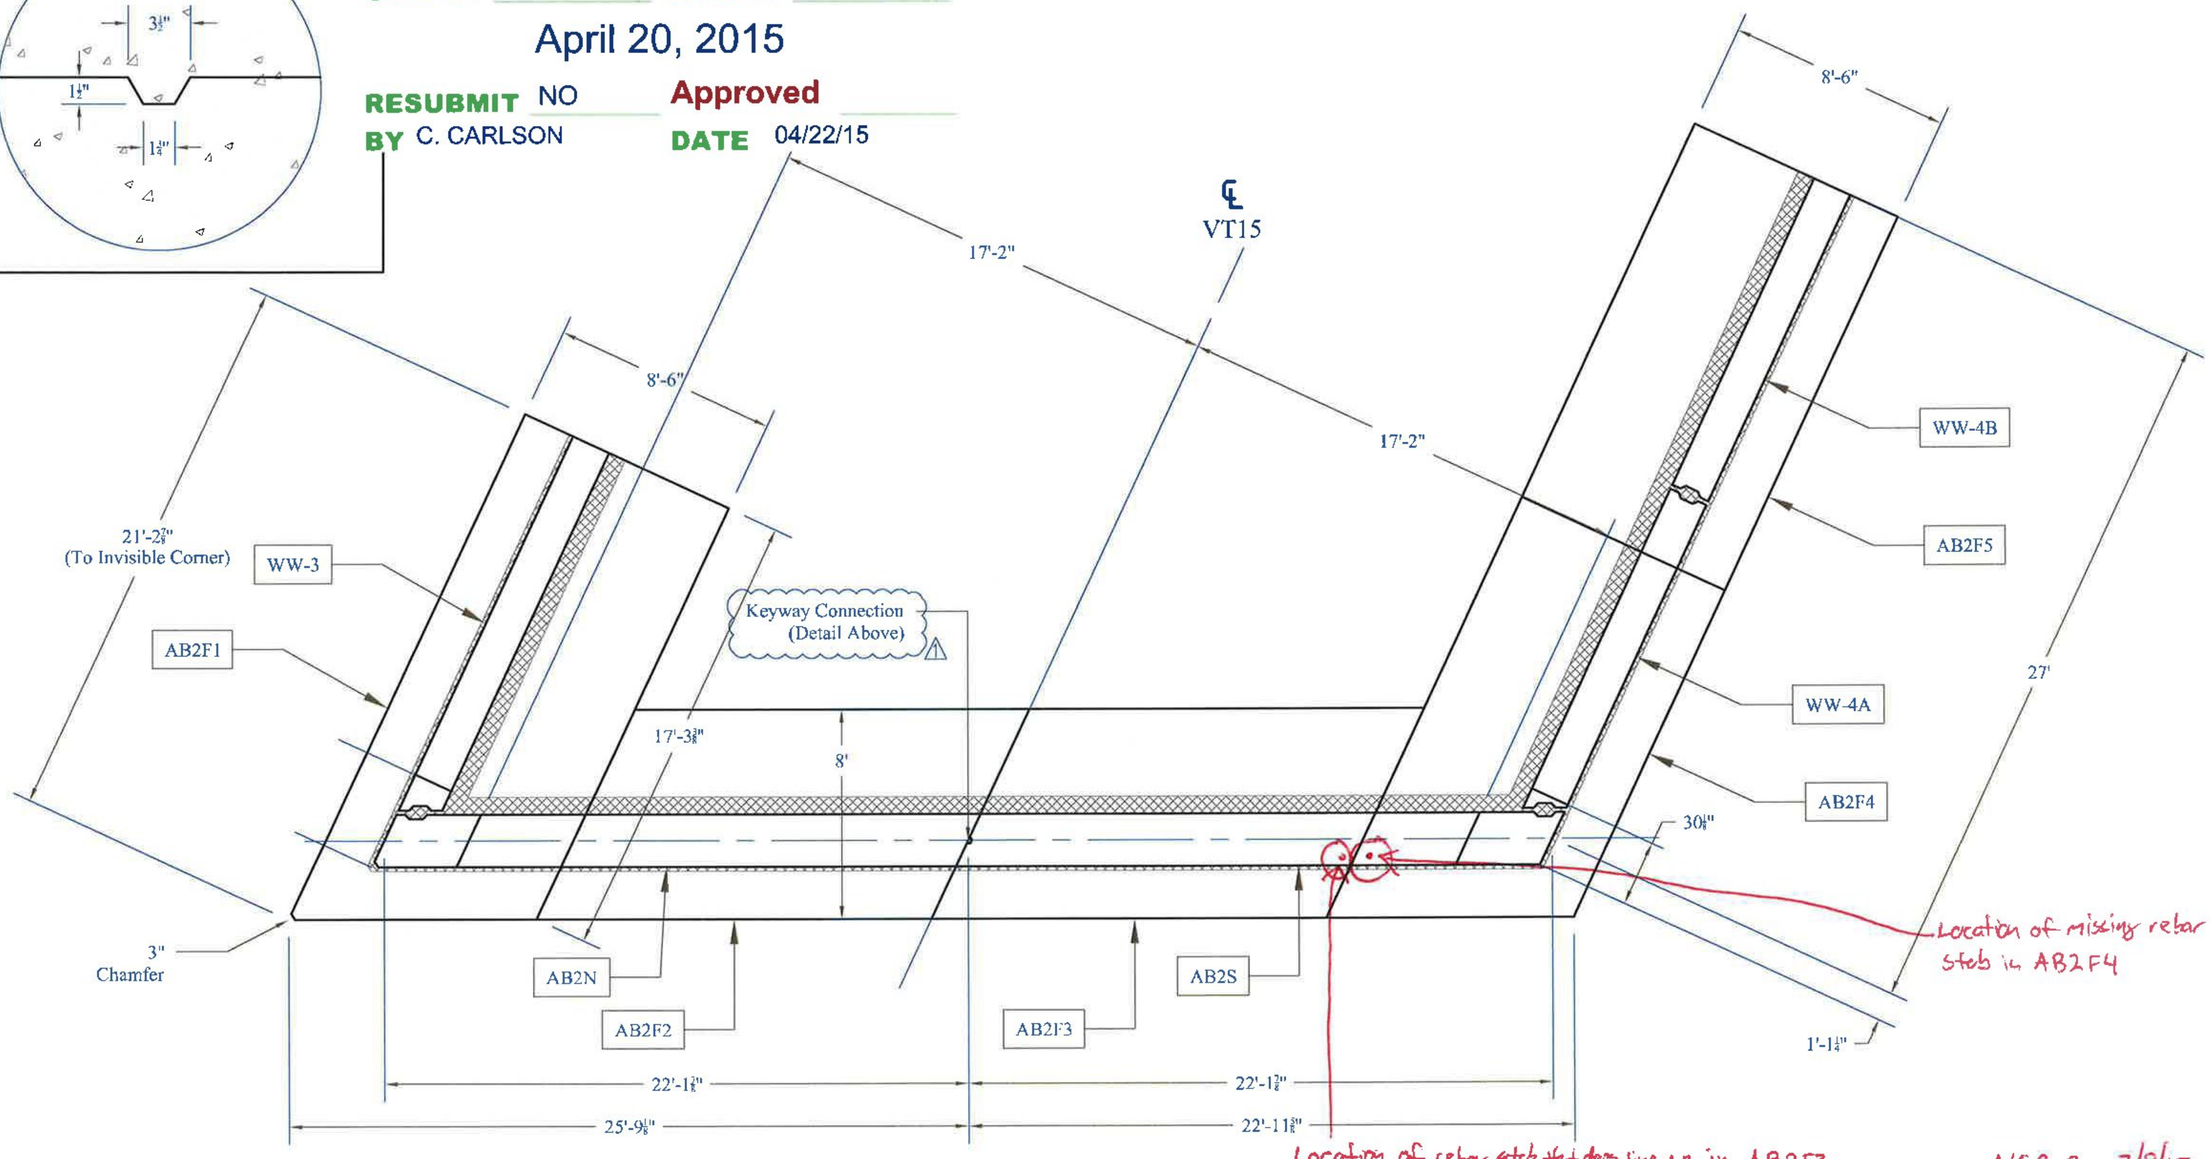

NCR 2 7/8/15

CONTRACTORS VTSPE:		Rev.	Date	By	Description
		1	04/16/15	IBA	Changes per State Review

PRECAST CONCRETE ABUTMENT SHOP DRAWINGS (SDI JOB #15801)

SUPERVISOR: E. Barendse
DETAILER: I. ADAMS
CHECKER: E. Barendse
ENGINEER: VTAOT

PROJECT NAME: Walden BRF 030-3(5)
PROJECT #: 030-3(5)
LOCATION: Walden, VT

INSTALLER:
J.A. McDonald, Inc.
PO Box 132
Lyndon Center, VT 05850

FABRICATOR:
193 INDUSTRIAL AVE.
WILLISTON, VT 05495
Ph: (802) 658-0201

SD Ireland PRECAST

04/08/15 | AB2_PLAN | 4_OF_25