STATE OF VERMONT
AGENCY OF TRANSPORTATION

TRAFFIC SIGN SUMMARY SHEET

MILEMARKER, STATION, OR SIGN NUMBER	SIGN LEGEND	SIGN DIMENSIONS EA	WIDTH (in)	HEIGHT (in)	NEW & SALVAGED SIGNS "A"	"B"	SALV SIGN	SALV TIS	EXIST POST RETAIN	SALVAGE	NEW SIGN POSTS NO. OF POSTS	FLANGED CHANNEL lb/ft 1.12	2.0	3.0	SQUARE STEEL (in) lb/ft 1.75	2.0	2.5	ANCHOR	SLEEVE	TUBULAR ALUMINUM Ø (in) lb/ft 3.0	4.0	4.0 MOD	FOUND-ATION	TUBULAR STEEL Ø (in) lb/ft 3.0	3.5	4.0	5.0	W-SHAPE STEEL FTG. SIZE 24"	30"	WEIGHT	POST SIZE	SIGNS REQUIRED	REMARKS	SIGN DETAIL DETAIL ON SHEET NUMBER	STD. SHEET NUMBER
												7.6	9.0	10.8	14.6																				
												OPTION ITEMS																							
01 02		2	36	36	18.0						4					48		4															W10-12 STANDARD HIGHWAY SIGNS		
03		1	36	36	9.0						2					24		2															W10-4R STANDARD HIGHWAY SIGNS		
04 05		2	24	36	12.0						2					24		2															R10-6 STANDARD HIGHWAY SIGNS		
06 07 08 09		7	48	9	21.0						0					0		0															R15-1		E-190
10 11 12		7	48	9	21.0						0					0		0															R15-1		E-190
13 14 15 16 17 18 19	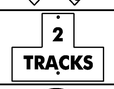	7	27	18	15.8						0					0		0															R15-2		E-190
20 21 22		3	36	36	21.3						6					72		6															W10-1 STANDARD HIGHWAY SIGNS		
23	TRUCK LANE 500 FEET						1			1																									
24	RT 7 NORTH						1			1																									