STATE OF VERMONT
AGENCY OF TRANSPORTATION

TRAFFIC SIGN SUMMARY SHEET 01

MILEMARKER, STATION, OR SIGN NUMBER	SIGN LEGEND	SIGN DIMENSIONS EA	SIGN DIMENSIONS WIDTH (in)	SIGN DIMENSIONS HEIGHT (in)	NEW & SALVAGED SIGNS "A"	NEW & SALVAGED SIGNS "B"	NEW & SALVAGED SIGNS SALV SIGN	NEW & SALVAGED SIGNS SALV TIS	EXIST POST RETAIN	EXIST POST SALVAGE	NO. OF POSTS	FLANGED CHANNEL lb/ft 1.12	FLANGED CHANNEL lb/ft 2.0	FLANGED CHANNEL lb/ft 3.0	SQUARE STEEL (in) lb/ft 1.75 1.88	SQUARE STEEL (in) lb/ft 2.0 2.42	SQUARE STEEL (in) lb/ft 2.5 3.35	ANCHOR	SLEEVE	TUBULAR ALUMINUM Ø (in) lb/ft 3.0 1.3	TUBULAR ALUMINUM Ø (in) lb/ft 4.0 1.7	TUBULAR ALUMINUM Ø (in) lb/ft 4.0 MOD 1.7	TUBULAR STEEL Ø (in) FOUND-ATION	TUBULAR STEEL Ø (in) lb/ft 3.0 7.6	TUBULAR STEEL Ø (in) lb/ft 3.5 9.0	TUBULAR STEEL Ø (in) lb/ft 4.0 10.8	TUBULAR STEEL Ø (in) lb/ft 5.0 14.6	W-SHAPE STEEL FTG. SIZE 24"	W-SHAPE STEEL FTG. SIZE 30"	W-SHAPE STEEL WEIGHT	W-SHAPE STEEL POST SIZE	SIGN FRAME REQUIRED	REMARKS	SIGN DETAIL DETAIL IN SHSM BOOK	SIGN DETAIL DETAIL ON SHEET NUMBER	SIGN DETAIL STD. SHEET NUMBER
SPRINGFIELD																																				
BASELINE 1																																				
101+47, ~~RT~~ LT		1	24	30	5.00						1					15		X															SIGN ID CODE VR-023b			E-144
		1	30	24	5.00																											SIGN ID CODE VR-032 "PROHIBITED" SIGN TO BE INSTALLED BELOW SIGN VR-023b.		19	
101+83, LT		1	24	32	5.33																											INSTALL SIGN ON LIGHT POLE		4	
101+83, LT&RT	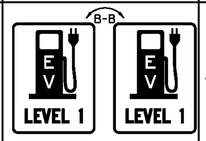	4	24	32	21.33																											INSTALL SIGNS ON LIGHT POLE		4	
101+83, RT		1	24	32	5.33																											INSTALL SIGN ON LIGHT POLE		4	
102+64, LT		1	24	32	5.33																											INSTALL SIGN ON LIGHT POLE		4	
102+64, LT&RT	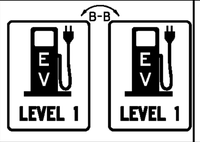	4	24	32	21.33																											INSTALL SIGNS ON LIGHT POLE		4	
102+64, RT		1	24	32	5.33																											INSTALL SIGN ON LIGHT POLE		4	
												FT	FT	FT	FT	FT 15	FT		EA	LB	LB	LB		LB	LB	LB	LB								
												FT			FT 15					LB			EA.	LB				EA.	EA.	LB					
		TOTALS			SF 73.98	SF	EA.	SF																												

FINAL POST LENGTHS ARE TO BE DETERMINED IN THE FIELD. POST SIZES ARE COMPUTED BASED ON INFORMATION FURNISHED ON THE STANDARD SHEETS AND THE VTRANS "SIGN POST DESIGN GUIDELINE."

Stantec

PROJECT NAME: SPRINGFIELD
PROJECT NUMBER: CMG PARK (32)

FILE NAME: z09K250frm.dgn
PROJECT LEADER: G. SANTY
DESIGNED BY: I. MAYNARD
TRAFFIC SIGN SUMMARY SHEET 1

PLOT DATE: 6/25/2014
DRAWN BY: I. MAYNARD
CHECKED BY: M. FOISY
SHEET 16 OF 43