STATE OF VERMONT
AGENCY OF TRANSPORTATION

TRAFFIC SIGN SUMMARY SHEET 02

MILEMARKER, STATION, OR SIGN NUMBER	SIGN LEGEND	SIGN DIMENSIONS EA	WIDTH (in)	HEIGHT (in)	NEW & SALVAGED SIGNS "A"	"B"	SALV SIGN	SALV TIS	EXIST POST RETAIN	EXIST POST SALVAGE	NEW SIGN POSTS NO. OF POSTS	FLANGED CHANNEL lb/ft 1.12	2.0	3.0	SQUARE STEEL (in) lb/ft 1.75	2.0	2.5	1.88	2.42	3.35	ANCHOR	SLEEVE	TUBULAR ALUMINUM Ø (in) lb/ft 3.0	4.0	4.0 MOD	1.3	1.7	1.7	TUBULAR STEEL Ø (in) FOUNDATION	3.0	3.5	4.0	5.0 lb/ft	7.6	9.0	10.8	14.6	W-SHAPE STEEL FTG. SIZE 24"	30"	WEIGHT	POST SIZE	SIGN FRAME REQUIRED	REMARKS	SIGN DETAIL DETAIL IN SHSM BOOK	DETAIL ON SHEET NUMBER	STD. SHEET NUMBER
SPRINGFIELD	
103+15, RT		2	12	18	3.00						1					15			X	X																								X		
103+31, RT		2 1	12 12	18 9	3.00 0.75						1					15			X	X																								SIGN ID CODE R7-8 "VAN ACCESSIBLE" SIGN TO BE INSTALLED BELOW SIGN R7-8. SIGN ID CODE R7-8P	X X		
103+36, LT		1	24	32	5.33																																							INSTALL SIGN ON LIGHT POLE		4	
103+36, LT&RT	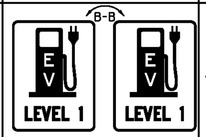	4	24	32	21.33																																							INSTALL SIGNS ON LIGHT POLE		4	
103+36, RT		1	24	32	5.33																																							INSTALL SIGN ON LIGHT POLE		4	
103+54, RT		1	12	18	1.50						1					15			X																								SIGN ID CODE R7-1	X		
103+69, RT		1	12	18	1.50						1					15			X																								SIGN ID CODE R7-1	X		
103+77, RT		1	12	18	1.50						1					15			X																								SIGN ID CODE R7-7L	X		
103+49, RT. RESERVED PARKING (REF. COD *01)			12	18	1.50				ID CODE R7-8			FT	FT	FT	FT	FT 75	FT		EA	LB	LB	LB		LB	LB	LB	LB																	
FINAL POST LENGTHS ARE TO BE DETERMINED IN THE FIELD. POST SIZES ARE COMPUTED BASED ON INFORMATION FURNISHED ON THE STANDARD SHEETS AND THE VTRANS "SIGN POST DESIGN GUIDELINE."		**TOTALS**			~~43.24~~ 44.74 SF	SF	EA.	SF				FT			FT 75					LB				EA.	LB				EA.	EA.	LB													

Stantec

PROJECT NAME: SPRINGFIELD
PROJECT NUMBER: CMG PARK (32)

FILE NAME: z09K250frm.dgn
PROJECT LEADER: G. SANTY
DESIGNED BY: I. MAYNARD
TRAFFIC SIGN SUMMARY SHEET 2

PLOT DATE: 6/25/2014
DRAWN BY: I. MAYNARD
CHECKED BY: M. FOISY
SHEET 17 OF 43