DIRECTION	MILEPOINT	LOCATION CODE (SHEET 2)	SIGN CODE	WIDTH (IN)	HEIGHT (IN)	SHEETING REMARKS	SIGN LEGEND	NEW SIGNS "A"	NEW SIGNS "B"	EXISTING SIGNS RETAIN	EXISTING SIGNS SALVAGE FROM	EXISTING SIGNS SALVAGE TO	EXISTING SIGNS REMOVE	EXIST POST RETAIN	EXIST POST REMOVE	NUMBER OF NEW POSTS	SQUARE STEEL (IN) 1.75 (LB/FT) 1.88	SQUARE STEEL (IN) 2.00 (LB/FT) 2.42	SQUARE STEEL (IN) 2.50 (LB/FT) 3.35	TUBULAR STEEL Ø (IN) FOUNDATION	TUBULAR STEEL Ø (IN) 3.00 (LB/FT) 7.60	TUBULAR STEEL Ø (IN) 3.50 (LB/FT) 9.00	TUBULAR STEEL Ø (IN) 4.00 (LB/FT) 10.80	TUBULAR STEEL Ø (IN) 5.00 (LB/FT) 14.60	SIGN FRAME REQUIRED	REMARKS	SIGN DETAIL LOCATION SHSM	SIGN DETAIL LOCATION PROJECT SHEET #	SIGN DETAIL LOCATION STANDARD SHEET #
ST ALBANS VT105 (SEYMOUR RD)							FY-FLUORESCENT YELLOW FYG-FLUORESCENT YELLOW GREEN																			"SHSM"-STANDARD HIGHWAY SIGNS AND MARKINGS			
WB	0.220	F	VW-622A	36	36		RECREATIONAL TRAIL						1		X														
		F	VW-622P	24	18		ALL SEASON PLAQUE						2 ~~1~~																
WB	0.127	F	W3-1	30	30								1		X														
		F	W3-1	30	30		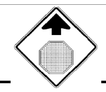	6.25								1		X									X	
WB	0.113	A	VW-622A	36	36		RECREATIONAL TRAIL						1		X														
		A	W1-7	21	15		<---> DOUBLE ARROW						1																
		A	W11-15a	30	30			6.25								1		X									X	
		A	W16-7pL	24	12			2.00																				X	
WB	0.080	G	VR-017	24	30		LEGAL LOAD LIMIT 24000 LBS			1				X													SAMANTHA LN (PVT)			
WB	0.075	H	R1-1	30	30		STOP			1				X													SAMANTHA LN (PVT)			
WB	0.066	F	M3-3	24	12		SOUTH						1		X														
		F	M1-4	24	24		US ROUTE 7						1																
		F	M4-5	24	12		TO						1																
		F	M3-3	24	12		SOUTH						1																
		F	M1-1	24	24		INTERSTATE 89						1																
							SHEET TOTALS	14.50	0.00	2	0	0	10	0	0	2		30.0			0	0.0	0.0	0.0	0.0				
								SF	SF	EA	EA	EA	EA	EA	EA	EA		FT			EA	LB	LB	LB	LB				
							TOWN DIRECTIONAL TOTALS	45.3	0.0	2	0	0	18	0	0	5		75.0			0	0.0							

SIGN SUMMARY SHEET

VERMONT AGENCY OF TRANSPORTATION

PROJECT NAME: **St Albans - Berkshire**
PROJECT NUMBER: **STPG SIGN(36)**

FILE NAME: **StAlbansAppWB.xls** PLOT DATE: **5/17/2011**
PROJECT MANAGER: **A. Gamble** DRAWN BY: **T. Guazzoni**
DESIGNED BY: **T. Guazzoni** CHECKED **A. Gamble**
ST ALBANS APP WB SHEET 1 SHEET **9** OF **109**