DIRECTION	MILEPOINT	LOCATION CODE (SHEET 2)	SIGN CODE	WIDTH (IN)	HEIGHT (IN)	SHEETING REMARKS	SIGN LEGEND	NEW SIGNS "A"	NEW SIGNS "B"	EXISTING SIGNS RETAIN	EXISTING SIGNS SALVAGE FROM	EXISTING SIGNS SALVAGE TO	EXISTING SIGNS REMOVE	EXIST POST RETAIN	EXIST POST REMOVE	NUMBER OF NEW POSTS	SQUARE STEEL (IN) 1.75 (LB / FT) 1.88	SQUARE STEEL (IN) 2.00 (LB / FT) 2.42	SQUARE STEEL (IN) 2.50 (LB / FT) 3.35	FOUNDATION	TUBULAR STEEL Ø (IN) 3.00 (LB / FT) 7.60	TUBULAR STEEL Ø (IN) 3.50 (LB / FT) SLIP BASE ~~9.00~~	TUBULAR STEEL Ø (IN) 4.00 (LB / FT) 10.80	TUBULAR STEEL Ø (IN) 5.00 (LB / FT) 14.60	SIGN FRAME REQUIRED	REMARKS	SIGN DETAIL LOCATION SHSM	SIGN DETAIL LOCATION PROJECT SHEET #	SIGN DETAIL LOCATION STANDARD SHEET #
ST ALBANS VT105 (SEYMOUR RD)							FY-FLUORESCENT YELLOW FYG-FLUORESCENT YELLOW GREEN																			"SHSM"-STANDARD HIGHWAY SIGNS AND MARKINGS			
		F	M6-1	21	15		LEFT						1															
		F	M3-1	24	12		NORTH						1															
		F	M1-4	24	24		US ROUTE 7						1															
		F	M4-5	24	12		TO						1															
		F	M3-1	24	12		NORTH						1															
		F	M1-1	24	24		INTERSTATE 89						1															
		F	M6-1	21	15		RIGHT						1															
		F	M3-3	24	12			2.00								2			X			2				#3	BLACK ON WHITE. INSTALL ASSEMBLY ON 2 1/2" SLIP BASES	X	6	
		F	M1-4	24	24			4.00																				E-136A
		F	M6-1L	21	15			2.19																			BLACK ON WHITE	X		
		F	M3-1	24	12			2.00																			BLACK ON WHITE	X		
		F	M1-4	24	24			4.00																				E-136A
		F	M6-1R	21	15		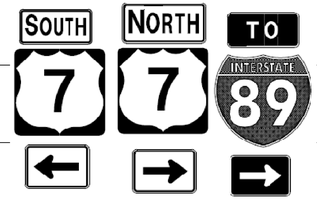	2.19																			BLACK ON WHITE	X		
		F	M4-5	24	12			2.00																			WHITE ON BLUE	X		
		F	M1-1	24	24			4.00																				X		
							SHEET TOTALS	22.38	0.00	0	0	0	7	0	0	2		30.0			0	0.0	~~0.0~~ 2	0.0	0.0				
								SF	SF	EA	EA	EA	EA	EA	EA	EA		FT			EA	LB	LB	LB	LB				
							TOWN DIRECTIONAL TOTALS	45.3	0.0	2	0	0	18	0	0	5		75.0			0	0.0							

SIGN SUMMARY SHEET

VERMONT AGENCY OF TRANSPORTATION

PROJECT NAME: St Albans - Berkshire
PROJECT NUMBER: STPG SIGN(36)

FILE NAME: StAlbansAppWB.xls
PROJECT MANAGER: A. Gamble
DESIGNED BY: T. Guazzoni
ST ALBANS APP WB SHEET 2

PLOT DATE: 5/17/2011
DRAWN BY: T. Guazzoni
CHECKED A. Gamble
SHEET 10 OF 109