DIRECTION	MILEPOINT	LOCATION CODE (SHEET 2)	SIGN CODE	WIDTH (IN)	HEIGHT (IN)	SHEETING REMARKS	SIGN LEGEND	NEW SIGNS "A"	NEW SIGNS "B"	EXISTING SIGNS RETAIN	EXISTING SIGNS SALVAGE FROM	EXISTING SIGNS SALVAGE TO	EXISTING SIGNS REMOVE	EXIST POST RETAIN	EXIST POST REMOVE	NUMBER OF NEW POSTS	SQUARE STEEL (IN) 1.75 (LB / FT) 1.88	SQUARE STEEL (IN) 2.00 (LB / FT) 2.42	SQUARE STEEL (IN) 2.50 (LB / FT) 3.35	FOUNDATION	TUBULAR STEEL Ø (IN) 3.00 (LB / FT) 7.60	TUBULAR STEEL Ø (IN) 3.50 (LB / FT) SLIP BASE ~~9.00~~	TUBULAR STEEL Ø (IN) 4.00 (LB / FT) 10.80	TUBULAR STEEL Ø (IN) 5.00 (LB / FT) 14.60	SIGN FRAME REQUIRED	REMARKS	SIGN DETAIL LOCATION SHSM	SIGN DETAIL LOCATION PROJECT SHEET #	SIGN DETAIL LOCATION STANDARD SHEET #
ST ALBANS TOWN VT105 EB							FY-FLUORESCENT YELLOW FYG-FLUORESCENT YELLOW GREEN																			"SHSM"-STANDARD HIGHWAY SIGNS AND MARKINGS			
		A	M4-5	24	12								1																
		A	M1-1	24	24								1																
		A	M6-1	21	15								1																
		A	M3-2	24	12			2.00								2			X			2			#3B	GREEN ON WHITE. INSTALL ON 2 1/2" SLIP BASES	X	6	
		A	M1-5	30	24			5.00																					E-136B
		A	M6-2L	21	15			2.19																		GREEN ON WHITE	X		
		A	M3-3	24	12			2.00																		GREEN ON WHITE	X		
		A	M1-5	30	24			5.00																					E-136B
		A	M6-1R	21	15		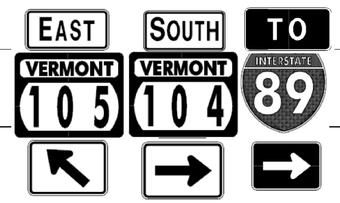	2.19																		GREEN ON WHITE	X		
		A	M4-5	24	12			2.00																		WHITE ON BLUE	X		
		A	M1-1	24	24			4.00																			X		
		A	M6-1R	21	15			2.19																		WHITE ON BLUE	X		
EB	1.434	A	R2-1	24	30			5.00								1		X								INSTALL SIGN 160' +/- WEST OF ROUTE MARKER ASSEMBLY	X		
EB	1.464	A	M3-2	24	12								1		X														
		A	M1-5	30	24								1																
							SHEET TOTALS	31.57	0.00	0	0	0	5	0	0	3		45.0		0	0.0	~~0.0~~ 2	0.0	0.0					
								SF	SF	EA	EA	EA	EA	EA	EA	EA		FT		EA	LB	LB	LB	LB					
							TOWN DIRECTIONAL TOTALS	215.5	0.0	0	0	0	47	0	0	32		480.0		0		0.0							

SIGN SUMMARY SHEET

VERMONT AGENCY OF TRANSPORTATION

PROJECT NAME: St Albans - Berkshire
PROJECT NUMBER: STPG SIGN(36)

FILE NAME: St. Albans EB.xls
PROJECT MANAGER: A. Gamble
DESIGNED BY: T. Guazzoni
ST ALBANS TOWN EB SHEET 5

PLOT DATE: 5/17/2011
DRAWN BY: T. Guazzoni
CHECKED A. Gamble
SHEET 16 OF 109