| DIRECTION | MILEPOINT | LOCATION CODE (SHEET 2) | SIGN CODE | WIDTH (IN) | HEIGHT (IN) | SHEETING REMARKS | SIGN LEGEND | NEW SIGNS | | EXISTING SIGNS | | | | EXIST POST | | NUMBER OF NEW POSTS | SQUARE STEEL (IN) | | | TUBULAR STEEL Ø (IN) | | | | SIGN FRAME REQUIRED | REMARKS | SIGN DETAIL LOCATION | | |
|---|---|---|---|---|---|---|---|---|---|---|---|---|---|---|---|---|---|---|---|---|---|---|---|---|---|---|---|
| | | | | | | | | "A" | "B" | RETAIN | SALVAGE FROM | SALVAGE TO | REMOVE | RETAIN | REMOVE | | 1.75 (LB / FT) 1.88 | 2.00 (LB / FT) 2.42 | 2.50 (LB / FT) 3.35 | FOUNDATION | 3.00 (LB / FT) 7.60 | 3.50 (LB / FT) 9.00 | 4.00 (LB / FT) 10.80 | 5.00 (LB / FT) 14.60 | | | SHSM | PROJECT SHEET # | STANDARD SHEET # |
| **ST ALBANS TOWN VT105 WB** | | | | | | | FY-FLUORESCENT YELLOW<br>FYG-FLUORESCENT YELLOW GREEN | | | | | | | | | | | | | | | | | | "SHSM"-STANDARD HIGHWAY SIGNS AND MARKINGS | | | |
| | | F | M1-4 | 24 | 24 | | | 4.00 | | | | | | | | | | | | | | | | | | | | E-136A |
| | | F | M6-2L | 21 | 15 | | | 2.19 | | | | | | | | | | | | | | | | | BLACK ON WHITE | X | | |
| | | F | M4-5 | 24 | 12 | | | 2.00 | | | | | | | | | | | | | | | | | BLACK ON WHITE | X | | |
| | | F | M3-1 | 24 | 12 | | | 2.00 | | | | | | | | | | | | | | | | | BLACK ON WHITE | X | | |
| | | F | M1-4 | 24 | 24 | | 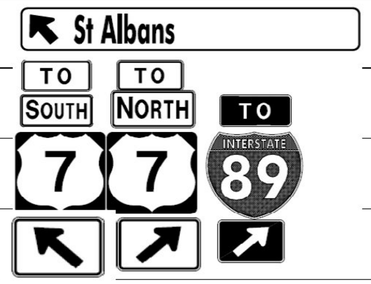 | 4.00 | | | | | | | | | | | | | | | | | | E-136A |
| | | F | M6-2R | 21 | 15 | | | 2.19 | | | | | | | | | | | | | | | | | BLACK ON WHITE | X | | |
| | | F | M4-5 | 24 | 12 | | | 2.00 | | | | | | | | | | | | | | | | | WHITE ON BLUE | X | | |
| | | F | M1-1 | 24 | 24 | | | 4.00 | | | | | | | | | | | | | | | | | | X | | |
| | | F | M6-2R | 21 | 15 | | | 2.19 | | | | | | | | | | | | | | | | | WHITE ON BLUE | X | | |
| WB | 0.285 | F | M3-3 | 24 | 12 | | SOUTH | | | | | | 1 | | X | | | | | | | | | | | | | |
| | | F | M1-4 | 24 | 24 | | US ROUTE 7 | | | | | | 1 | | | | | | | | | | | | | | | |
| | | F | M4-5 | 24 | 12 | | TO | | | | | | 1 | | | | | | | | | | | | | | | |
| | | F | M3-3 | 24 | 12 | | SOUTH | | | | | | 1 | | | | | | | | | | | | | | | |
| | | F | M1-1 | 24 | 24 | | INTERSTATE 89 | | | | | | 1 | | | | | | | | | | | | | | | |
| | | F | M6-2 | 21 | 15 | | LEFT ARROW (45 DEG) | | | | | | 1 | | | | | | | | | | | | | | | |
| | | | | | | | SHEET TOTALS | 24.57 | 0.00 | 0 | 0 | 0 | 6 | 0 | 0 | 0 | 0.0 | | | 0 | 0.0 | 0.0 | 0.0 | 0.0 | | | | |
| | | | | | | | | SF | SF | EA | EA | EA | EA | EA | EA | EA | | FT | | EA | LB | LB | LB | LB | | | | |
| | | | | | | | TOWN DIRECTIONAL TOTALS | 242.2 | 0.0 | 1 | 0 | 0 | 69 | 0 | 0 | 26 | 390.0 | | | 4 | 433.2 | | | | | | | |

**SIGN SUMMARY SHEET**

VERMONT AGENCY OF TRANSPORTATION

PROJECT NAME: St Albans - Berkshire
PROJECT NUMBER: STPG SIGN(36)
FILE NAME: StAlbansWB.xls
PROJECT MANAGER: A. Gamble
DESIGNED BY: T. Guazzoni
ST ALBANS TOWN WB SHEET 6
PLOT DATE: 5/17/2011
DRAWN BY: T. Guazzoni
CHECKED A. Gamble
SHEET 24 OF 109