DIRECTION	MILEPOINT	LOCATION CODE (SHEET 2)	SIGN CODE	WIDTH (IN)	HEIGHT (IN)	SHEETING REMARKS	SIGN LEGEND	NEW SIGNS		EXISTING SIGNS				EXIST POST		NUMBER OF NEW POSTS	SQUARE STEEL (IN)			TUBULAR STEEL Ø (IN)					SIGN FRAME REQUIRED	REMARKS	SIGN DETAIL LOCATION		
																	1.75	2.00	2.50	3.00	3.50	4.00	5.00					
																	(LB / FT)			(LB / FT)								
								"A"	"B"	RETAIN	SALVAGE FROM	SALVAGE TO	REMOVE	RETAIN	REMOVE		1.88	2.42	3.35	FOUNDATION 7.60	SLIP BASE ~~9.00~~	10.80	14.60				SHSM	PROJECT SHEET #	STANDARD SHEET #
ST ALBANS TOWN VT105 WB							FY-FLUORESCENT YELLOW FYG-FLUORESCENT YELLOW GREEN																			"SHSM"-STANDARD HIGHWAY SIGNS AND MARKINGS			
		F	M1-1	24	24		INTERSTATE 89						1															
		F	M6-1	21	15		RIGHT						1															
		F	M3-3	24	12			2.00								2			X		2			#3	BLACK ON WHITE. INSTALL ON 2 1/2" SLIP BASES	X	6	
		F	M1-4	24	24			4.00																				E-136A
		F	M6-1L	21	15			2.19																	BLACK ON WHITE	X		
		F	M3-1	24	12			2.00																	BLACK ON WHITE	X		
		F	M1-4	24	24			4.00																				E-136A
		F	M6-1R	21	15			2.19																	BLACK ON WHITE	X		
		F	M4-5	24	12		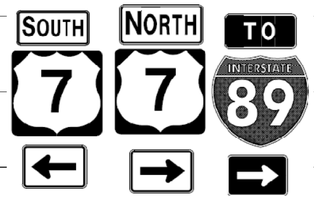	2.00																	WHITE ON BLUE	X		
		F	M1-1	24	24			4.00																		X		
		F	M6-1R	21	15			2.19																	WHITE ON BLUE	X		
WB	0.030	G	VM-607	24	30		PEARL HARBOR MEMORIAL HIGHWAY						1		X													
WB	0.000	F	R1-1	30	30		MM 				~~1~~		~~1~~ 2		X													
		F	R1-1	30	30			6.25								1		X								X		
SIGN SUMMARY SHEET							SHEET TOTALS	30.82	0.00	0	0	~~1~~ 0	~~5~~ 4	0	0	3	45.0			0	0.0	~~2~~ 0.0	0.0	0.0					
								SF	SF	EA	EA	EA	EA	EA	EA	EA		FT		EA	LB	LB	LB	LB					
VERMONT AGENCY OF TRANSPORTATION							TOWN DIRECTIONAL TOTALS	242.2	0.0	1	0	0	69	0	0	26	390.0			4	433.2								

PROJECT NAME: **St Albans - Berkshire**
PROJECT NUMBER: **STPG SIGN(36)**
FILE NAME: **StAlbansWB.xls**
PROJECT MANAGER: **A. Gamble**
DESIGNED BY: **T. Guazzoni**
PLOT DATE: **5/17/2011**
DRAWN BY: **T. Guazzoni**
CHECKED **A. Gamble**
ST ALBANS TOWN WB SHEET 9
SHEET **27** OF **109**