DIRECTION	MILEPOINT	LOCATION CODE (SHEET 2)	SIGN CODE	WIDTH (IN)	HEIGHT (IN)	SHEETING REMARKS	SIGN LEGEND	NEW SIGNS		EXISTING SIGNS				EXIST POST		NUMBER OF NEW POSTS	SQUARE STEEL (IN)			TUBULAR STEEL Ø (IN)				SIGN FRAME REQUIRED	REMARKS	SIGN DETAIL LOCATION		
																	1.75	2.00	2.50	3.00	3.50	4.00	5.00					
																	(LB / FT)			(LB / FT)								
								"A"	"B"	RETAIN	SALVAGE FROM	SALVAGE TO	REMOVE	RETAIN	REMOVE		1.88	2.42	3.35	FOUNDATION	7.60	SLIP BASE ~~9.00~~	10.80	14.60			SHSM	PROJECT SHEET #	STANDARD SHEET #
SHELDON VT105 WB							FY-FLUORESCENT YELLOW FYG-FLUORESCENT YELLOW GREEN																		"SHSM"-STANDARD HIGHWAY SIGNS AND MARKINGS			
		F	M3-1	24	12								1															
		F	M1-5	30	24								1															
		F	M6-1	21	15								1															
		F	M3-4	24	12			2.00								2		X						#2B	GREEN ON WHITE	X		
		F	M1-5	30	24			5.00																				E-136B
		F	M6-3	21	15			2.19																	GREEN ON WHITE	X		
		F	M3-1	24	12		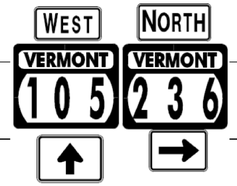	2.00																	GREEN ON WHITE	X		
		F	M1-5	30	24			5.00																				E-136B
		F	M6-1	21	15			2.19																	GREEN ON WHITE	X		
WB	8.700	F	M3-4	24	12		ROUTE MARKERS (2)						1		X													
		F	M1-5	30	24								1															
		F	VD2-1	72	12			6.00								2			X			2			INSTALL ON 2 1/2" SLIP BASES		4	
		F	VD2-1	72	12		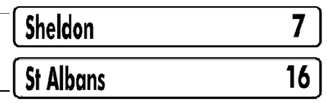	6.00																				4	
		F	M3-4	24	12			2.00																	GREEN ON WHITE	X		
		F	M1-5	30	24			5.00																				E-136B
							SHEET TOTALS	37.38	0.00	0	0	0	5	0	0	4		60.0		0	0.0	2 0.0	0.0	0.0					
								SF	SF	EA	EA	EA	EA	EA	EA	EA		FT		EA	LB	LB	LB	LB					
							TOWN DIRECTIONAL TOTALS	488.5	0.0	48	7	7	103	0	0	81		1215.0		0		0.0							

SIGN SUMMARY SHEET

VERMONT AGENCY OF TRANSPORTATION

PROJECT NAME: **St Albans - Berkshire**
PROJECT NUMBER: **STPG SIGN(36)**

FILE NAME: **SheldonWB.xls**
PROJECT MANAGER: **A. Gamble**
DESIGNED BY: **T. Guazzoni**
DRAWN BY: **T. Guazzoni**
CHECKED **A. Gamble**
PLOT DATE: **5/17/2011**