DIRECTION	MILEPOINT	LOCATION CODE (SHEET 2)	SIGN CODE	WIDTH (IN)	HEIGHT (IN)	SHEETING REMARKS	SIGN LEGEND	NEW SIGNS "A"	NEW SIGNS "B"	EXISTING SIGNS RETAIN	EXISTING SIGNS SALVAGE FROM	EXISTING SIGNS SALVAGE TO	EXISTING SIGNS REMOVE	EXIST POST RETAIN	EXIST POST REMOVE	NUMBER OF NEW POSTS	SQUARE STEEL (IN) 1.75 (LB / FT) 1.88	SQUARE STEEL (IN) 2.00 (LB / FT) 2.42	SQUARE STEEL (IN) 2.50 (LB / FT) 3.35	FOUNDATION	TUBULAR STEEL Ø (IN) 3.00 (LB / FT) 7.60	TUBULAR STEEL Ø (IN) 3.50 (LB / FT) SLIP BASE ~~9.00~~	TUBULAR STEEL Ø (IN) 4.00 (LB / FT) 10.80	TUBULAR STEEL Ø (IN) 5.00 (LB / FT) 14.60	SIGN FRAME REQUIRED	REMARKS	SIGN DETAIL LOCATION SHSM	SIGN DETAIL LOCATION PROJECT SHEET #	SIGN DETAIL LOCATION STANDARD SHEET #
SHELDON VT105 WB							FY-FLUORESCENT YELLOW FYG-FLUORESCENT YELLOW GREEN																			"SHSM"-STANDARD HIGHWAY SIGNS AND MARKINGS			
		F	VD2-1	72	12			6.00								2			X			2				INSTALL ON 2 1/2" SLIP BASES		4	
		F	VD2-1	72	12		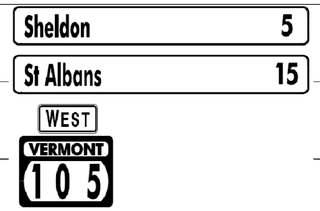	6.00																				4	
		F	M3-4	24	12			2.00																		GREEN ON WHITE	X		
		F	M1-5	24	30			5.00																					E-136B
WB	6.600	F	R2-1	24	30		SPEED LIMIT 50						1		X														
WB	6.580	F	R2-1	24	30			5.00								1		X								INSTALL NEW SIGN 100' +/- WEST OF EXISTING LOCATION	X		
WB	6.500	F	W11-6H	30	30								1		X														
		F	W11-6H	30	30			6.25								1		X								INSTALL IN CLOSED POSITION, 530' +/- WEST OF EXISTING 50 MPH SIGN			E-153
WB	6.040	F	VR-072	24	30								1		X														
		F	VR-072	24	30			5.00								1		X										7	
WB	5.640	F	VR-072	24	30								1		X														
		F	VR-072	24	30			5.00								1		X										7	
WB	5.250	G	VR-017	24	24		LEGAL LOAD LIMIT 24000 LBS			1				X												DANYOW RD (TH-39)			
WB	5.240	H	R1-1	30	30		STOP			1				X												DANYOW RD (TH-39)			
WB	5.130	F	W1-2MbR	36	36		MODIFIED RIGHT CURVE				1		1		X											SALVAGE SIGN TO MP 5.04 +/-			
							SHEET TOTALS	40.25	0.00	2	1	0	5	0	0	6	90.0			0	0.0	~~0.0~~ 2	0.0	0.0				
								SF	SF	EA	EA	EA	EA	EA	EA	EA	FT			EA	LB	LB	LB	LB				
							TOWN DIRECTIONAL TOTALS	488.5	0.0	48	7	7	103	0	0	81	1215.0			0	0.0							

SIGN SUMMARY SHEET

VERMONT AGENCY OF TRANSPORTATION

PROJECT NAME: **St Albans - Berkshire**
PROJECT NUMBER: **STPG SIGN(36)**

FILE NAME: **SheldonWB.xls** PLOT DATE: **5/17/2011**
PROJECT MANAGER: **A. Gamble** DRAWN BY: **T. Guazzoni**
DESIGNED BY: **T. Guazzoni** CHECKED **A. Gamble**
SHELDON WB SHEET 7 SHEET **55** OF **109**