DIRECTION	MILEPOINT	LOCATION CODE (SHEET 2)	SIGN CODE	WIDTH (IN)	HEIGHT (IN)	SHEETING REMARKS	SIGN LEGEND	NEW SIGNS		EXISTING SIGNS				EXIST POST		NUMBER OF NEW POSTS	SQUARE STEEL (IN)			TUBULAR STEEL Ø (IN)				SIGN FRAME REQUIRED	REMARKS	SIGN DETAIL LOCATION		
																	1.75	2.00	2.50	3.00	3.50	4.00	5.00					
																	(LB / FT)			(LB / FT)								
								"A"	"B"	RETAIN	SALVAGE FROM	SALVAGE TO	REMOVE	RETAIN	REMOVE		1.88	2.42	3.35	FOUNDATION	7.60	SLIP BASE 9.00	10.80	14.60			SHSM	PROJECT SHEET #	STANDARD SHEET #
ENOSBURG VT105 EB							FY-FLUORESCENT YELLOW FYG-FLUORESCENT YELLOW GREEN																		"SHSM"-STANDARD HIGHWAY SIGNS AND MARKINGS			
		A	M6-1L	21	15								1															
		A	M3-3	24	12								1															
		A	M1-5	30	24								1															
		A	M6-1R	21	15								1															
		A	M3-2	24	12			~~2.19~~ 2.00								2			X					#3C	GREEN ON WHITE. INSTALL ON 2 1/2" SLIP BASES	X		
		A	M1-5	30	24			5.00																				E-136B
		A	M6-1L	21	15			2.19																	GREEN ON WHITE	X		
		A	M3-1	24	12			2.00														2			GREEN ON WHITE	X		
		A	M1-5	30	24			5.00																				E-136B
		A	M6-1L	21	15		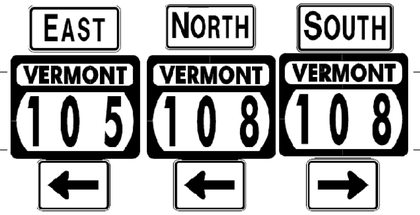	2.19																	GREEN ON WHITE	X		
		A	M3-3	24	12			2.00																	GREEN ON WHITE	X		
		A	M1-5	30	24			5.00																				E-136B
		A	M6-1R	21	15			2.19																	GREEN ON WHITE	X		
EB	0.690	A	R1-1	30	30								1		X													
		C	M1-5	30	24		VERMONT 105						1															
							SHEET TOTALS	~~27.76~~ 27.57	0.00	0	0	0	6	0	0	2	30.0			0	0.0	~~0.0~~ 2	0.0	0.0					
								SF	SF	EA	EA	EA	EA	EA	EA	EA	FT			EA	LB	LB	LB	LB					
							TOWN DIRECTIONAL TOTALS	393.9	0.0	25	4	4	94	0	0	58	870.0			2	235.6								

SIGN SUMMARY SHEET

VERMONT AGENCY OF TRANSPORTATION

PROJECT NAME: St Albans - Berkshire
PROJECT NUMBER: STPG SIGN(36)

FILE NAME: EnosburgEB.xls
PROJECT MANAGER: A. Gamble
DESIGNED BY: T. Guazzoni
ENOSBURG EB SHEET 5

PLOT DATE: 5/17/2011
DRAWN BY: T. Guazzoni
CHECKED A. Gamble
SHEET 70 OF 109